MISSISSIPPI DEPARTMENT OF NATURAL RESOURCES

Bureau of Land and Water Resources

P.O. Box 10631
Jackson, Mississippi 39209

WATER WELL DRILLERS LOG

COUNTY WELL LOCATED: Harrison

WELL NUMBER: K 2065 | CODED:

DATE WELL COMPLETED: June 16-87

PERMIT NUMBER: D-239

NAME OF DRILLING FIRM: MCGILL PUMP & [illegible]
RTI BOX 1643 CANAL RD
GULPT, MS 39503

NAME & MAILING ADDRESS OF LANDOWNER:
LaSondra Ledet
Rt. 1, Box 712C
Saucier, Ms.

WELL LOCATION: SEC 11 TOWNSHIP 7 N (S) RANGE 12 E (W)

DISTANCE 6 Miles DIRECTION NW of NEAREST TOWN Lyon

OTHER LANDMARK:

WELL PURPOSE: (Home) Irrigation, Municipal, Industrial, Fish Pond, etc.

PUMP DATA

PUMP TYPE (Circle One): Submersible, Turbine, (Jet) Flowing Well, Other (Describe) _____

POWER TYPE (Circle One): Electric, Tractor, Diesel, Gasoline, Butane, Other (Describe) _____

Pump Capacity (GPM)	No. of Stages	Setting Depth
13	2	100' FT.

PUMP TEST

Well yielded 8 GPM with a drawdown of 10 ft. after 1 hours of pumping

WELL DATA

Well Depth	Casing Diameter (In.)	Casing Length (Ft.)
480'	2"	480'

Type of Casing	Hole Depth	Depth to Static Water Level
PVC	480'	70'

TYPE OF COMPLETION: (Circle One or More): Gravel Packed, Underreamed, Telescoped, (Natural Development), Open Hole, Other (Describe) _____

Top of Lap Pipe or Reduction in Casing: FEET

IF TELESCOPED OR MORE THAN ONE SCREEN: USE BACK PAGE

SCREEN DATA

Diameter - Inches	Length - Feet	Slot Size - Inches
2"	10'	6 Ths

Screen Type	Depth to Bottom - Feet
PVC	480'

LOG DATA

TYPE OF LOG RUN: (Circle One): Nothing Run, Electric, Gamma Ray, Density, Sonic, Neutron, Other (Describe) _____

Name of Organization Running Log

GEOLOGIC DATA (Office Use Only)

Surface Elev.	Geologic Unit	Unit Thickness	Depth to Top
Subs. SWL	Date	Analysis	Aquifer Test

Driller's Remarks

DESCRIPTION OF FORMATIONS ENCOUNTERED	FROM	TO
Mud	[illegible]	450
Sand	45[illegible]	480

FORMATIONS (Continued)	FROM	TO

IF MORE SPACE IS NEEDED, USE BACK

RECEIVED
JUL 24 1987
Department of Natural Resources
Bureau of Land & Water Resources

If well telescopes please sketch and show depths.

GROUND LEVEL

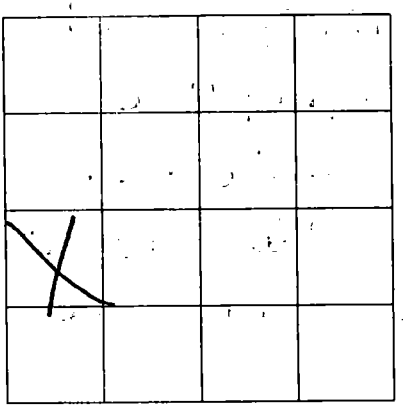

SECTION _____

Please indicate well location X.

ADDITIONAL INFORMATION

If more than one screen, show location of each on sketch.