MISSISSIPPI DEPARTMENT OF NATURAL RESOURCES

Bureau of Land and Water Resources

P.O. Box 10631
Jackson, Mississippi 39209

WATER WELL DRILLERS LOG

COUNTY WELL LOCATED: Harrison	PERMIT NUMBER:
WELL NUMBER: K 2087 CODED	NAME OF DRILLING FIRM: MCGILL PUMP & WELLS RT1 BOX 1643 CANAL RD GULPT, MS 39503
DATE WELL COMPLETED: Sept. 31-87	

NAME & MAILING ADDRESS OF LANDOWNER: Bill Garrett, Canal Rd., Gulf. MS.

WELL LOCATION: SEC 18 TOWNSHIP 7 (N) (S) RANGE 12 (E) (W)

DISTANCE: 3 Miles DIRECTION: West of NEAREST TOWN: Gulf.

OTHER LANDMARK: Corner I-10 & Canal Rd

WELL PURPOSE: (Home) Irrigation, Municipal, Industrial, Fish Pond, etc.

PUMP DATA

PUMP TYPE (Circle One): Submersible, Turbine, (Jet) Flowing Well, Other (Describe) _____

POWER TYPE (Circle One): (Electric) Tractor, Diesel, Gasoline, Butane, Other (Describe) _____

Pump Capacity (GPM)	No. of Stages	Setting Depth
15	2	20' FT.

PUMP TEST

Well yielded 15 GPM with a drawdown of 8 ft. after 1 hours of pumping

WELL DATA

Well Depth	Casing Diameter (In.)	Casing Length (Ft.)
150'	2"	140'

Type of Casing	Hole Depth	Depth to Static Water Level
PVC	150'	5'

TYPE OF COMPLETION: (Circle One or More): Gravel Packed, Underreamed, Telescoped, (Natural Development) Open Hole, Other (Describe) _____

Top of Lap Pipe or Reduction in Casing FEET

IF TELESCOPED OR MORE THAN ONE SCREEN: USE BACK PAGE

SCREEN DATA

Diameter - Inches	Length - Feet	Slot Size - Inches
2"	10'	60ths

Screen Type	Depth to Bottom - Feet
PVC	150'

LOG DATA

TYPE OF LOG RUN (Circle One): (No Log Run) Electric, Gamma Ray, Density, Sonic, Neutron, Other (Describe) _____

Name of Organization Running Log

GEOLOGIC DATA (Office Use Only)

Surface Elev.	Geologic Unit	Unit Thickness	Depth to Top
Subs. SWL	Date	Analysis	Aquifer Test

Driller's Remarks

RECEIVED JAN 4 1988 Department of Natural Resources Bureau of Land & Water Resources

DESCRIPTION OF FORMATIONS ENCOUNTERED	FROM	TO
Mud	0	130
Sand	130	150

FORMATIONS (Continued)	FROM	TO

IF MORE SPACE IS NEEDED, USE BACK

If well telescopes please
sketch and show depths.

GROUND LEVEL

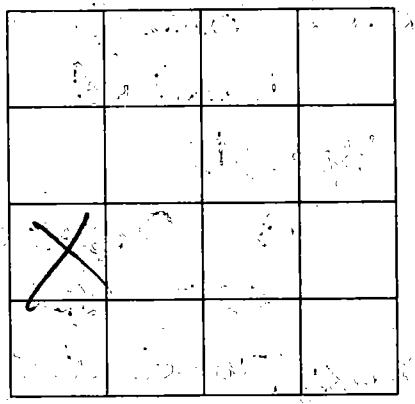

SECTION _____

Please indicate well location X.

ADDITIONAL INFORMATION

If more than one screen,
show location of each on sketch.