MISSISSIPPI DEPARTMENT OF NATURAL RESOURCES

Bureau of Land and Water Resources

P.O. Box 10631
Jackson, Mississippi 39209

WATER WELL DRILLERS LOG

COUNTY WELL LOCATED: Harrison	
WELL NUMBER: K	CODED:
2095	PERMIT NUMBER:
DATE WELL COMPLETED: 11/5/87	NAME OF DRILLING FIRM: Lymon Well. Co

NAME & MAILING ADDRESS OF LANDOWNER
Stephen Delaney Sr.
Lot 15, London Lake Estates
Gpt, 39603

WELL LOCATION: SEC 13 TOWNSHIP 7 N (S) RANGE 12 E (W)

DISTANCE 4 Miles DIRECTION North of NEAREST TOWN Gulfport

OTHER LANDMARK

WELL PURPOSE: Home, Irrigation, Municipal, Industrial, Fish Pond, etc.

PUMP DATA

PUMP TYPE (Circle One): Submersible, Turbine, Jet, Flowing Well, Other (Describe) _____

POWER TYPE (Circle One): Electric, Tractor, Diesel, Gasoline, Butane, Other (Describe) _____

Pump Capacity (GPM)	No. of Stages	Setting Depth
		FT.

PUMP TEST

Well yielded _____ GPM with a drawdown of _____ ft. after _____ hours of pumping

WELL DATA

Well Depth	Casing Diameter (In.)	Casing Length (Ft.)
230'	2"	220'

Type of Casing	Hole Depth	Depth to Static Water Level
PVC	230'	31

TYPE OF COMPLETION: (Circle One or More): Gravel Packed, Underreamed, Telescoped, Natural Development, Open Hole, Other (Describe) _____

Top of Lap Pipe or Reduction in Casing FEET

IF TELESCOPED OR MORE THAN ONE SCREEN: USE BACK PAGE

LOG DATA

TYPE OF LOG RUN (Circle One): No Log Run, Electric, Gamma Ray, Density, Sonic, Neutron, Other (Describe) _____

Name of Organization Running Log

GEOLOGIC DATA (Office Use Only)

Surface Elev.	Geologic Unit	Unit Thickness	Depth to Top
Subs. SWL	Date	Analysis	Aquifer Test

Driller's Remarks: None

SCREEN DATA

Diameter - Inches	Length - Feet	Slot Size - Inches
2"	10'	.006

Screen Type	Depth to Bottom - Feet
PVC. sawed slotted	230'

DESCRIPTION OF FORMATIONS ENCOUNTERED	FROM	TO
Top soil	0'	1'
Sandy clay	1'	11'
Clay	11'	21'
Sand	21'	27'
Clay	27'	88'
Sandy clay	88'	165'
Clay	165	202'
Sand	202'	230'

FORMATIONS (Continued) FROM TO

IF MORE SPACE IS NEEDED, USE BACK

RECEIVED
FEB 22 1988
Department of Natural Resources
Bureau of Land & Water Resources

If well telescopes please
sketch and show depths.

GROUND LEVEL

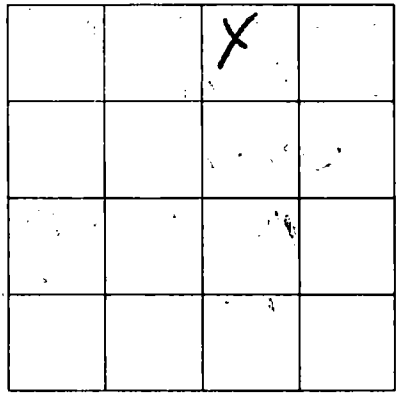

SECTION 13

Please indicate well location X.

ADDITIONAL INFORMATION

If more than one screen,
show location of each on sketch.