MISSISSIPPI DEPARTMENT OF NATURAL RESOURCES

Bureau of Land and Water Resources

P.O. Box 10631
Jackson, Mississippi 39209

WATER WELL DRILLERS LOG

COUNTY WELL LOCATED: Harrison	PERMIT NUMBER:
WELL NUMBER: K 2112 — CODED:	NAME OF DRILLING FIRM: H&B Drilling Co.
DATE WELL COMPLETED: 4-5-89	Broden Pump & Well Serv.

NAME & MAILING ADDRESS OF LANDOWNER
Dennis Blackwell
22041 Anette Lane
Pass Christian, Miss

WELL LOCATION: SEC 32 TOWNSHIP 7 S RANGE 12 W

DISTANCE 2 Miles DIRECTION NE of NEAREST TOWN Cuevas

OTHER LANDMARK

WELL PURPOSE: Home, Irrigation, Municipal, Industrial, Fish Pond, etc.
Home

PUMP DATA

PUMP TYPE (Circle One): Submersible, Turbine, (Jet) Flowing Well, Other (Describe) _____

POWER TYPE (Circle One): (Electric) Tractor, Diesel, Gasoline, Butane, Other (Describe) _____ H/P _____

Pump Capacity (GPM)	No. of Stages	Setting Depth
Customer Set Pump		FT.

PUMP TEST

Well yielded _____ GPM with

a drawdown of _____ ft.

after _____ hours of pumping

WELL DATA

Well Depth	Casing Diameter (In.)	Casing Length (Ft.)
360	2"	340
Type of Casing	**Hole Depth**	**Depth to Static Water Level**
PVC	360	26'

TYPE OF COMPLETION: (Circle One or More): Gravel Packed, Underreamed, Telescoped, (Natural Development), Open Hole, Other (Describe) _____

Top of Lap Pipe or Reduction in Casing FEET

IF TELESCOPED OR MORE THAN ONE SCREEN: USE BACK PAGE

LOG DATA

TYPE OF LOG RUN (Circle One): (No Log Run) Electric, Gamma Ray, Density, Sonic, Neutron, Other (Describe) _____

Name of Organization Running Log

GEOLOGIC DATA (Office Use Only)

Surface Elev.	Geologic Unit	Unit Thickness	Depth to Top
Subs. SWL	Date	Analysis	Aquifer Test

Driller's Remarks

SCREEN DATA

Diameter - Inches	Length - Feet	Slot Size - Inches
2"	10	.008
Screen Type		**Depth to Bottom - Feet**
PVC WOP		

DESCRIPTION OF FORMATIONS ENCOUNTERED	FROM	TO	FORMATIONS (Continued)	FROM	TO
Surface Clay	0	10			
Sand	10	32			
Blue Grey Clay	32	310			
Grey Sand	310	356			
Blue Clay	356	360			
			IF MORE SPACE IS NEEDED, USE BACK		

RECEIVED
APR 21 1989
Dept. of Natural Resources
Bureau of Land & Water Resources

If well telescopes please sketch and show depths.

GROUND LEVEL

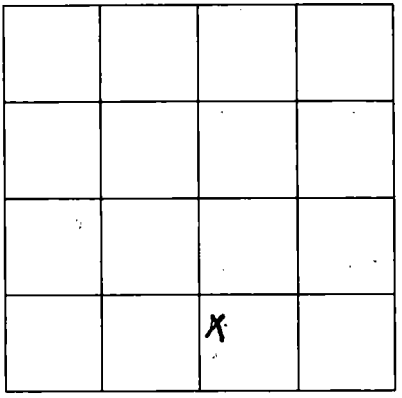

SECTION 32

Please indicate well location X.

ADDITIONAL INFORMATION

If more than one screen, show location of each on sketch.