MISSISSIPPI DEPARTMENT OF NATURAL RESOURCES

Bureau of Land and Water Resources

P.O. Box 10631
Jackson, Mississippi 39209

WATER WELL DRILLERS LOG

COUNTY WELL LOCATED: Harrison

WELL NUMBER: K2124 | CODED:

PERMIT NUMBER: O-493

NAME OF DRILLING FIRM: Bobby Beck's Well Works Inc.

DATE WELL COMPLETED: 2-16-90

NAME & MAILING ADDRESS OF LANDOWNER:
Alan Hiscoe
22281 Mercedes Lane
Lyn. MS 39501

WELL LOCATION: SEC 5 TOWNSHIP 7 N/S RANGE 12 E/(W)

DISTANCE ____ Miles DIRECTION ____ of NEAREST TOWN ____

OTHER LANDMARK

WELL PURPOSE: Home, Irrigation, Municipal, Industrial, Fish Pond, etc.

PUMP DATA

PUMP TYPE (Circle One): Submersible, Turbine, Jet, Flowing Well, Other (Describe) 1 HP 2 Stage

POWER TYPE (Circle One): (Electric), Tractor, Diesel, Gasoline, Butane, Other (Describe) ____

Pump Capacity (GPM)	No. of Stages	Setting Depth
1	2	FT.

PUMP TEST

Well yielded ____ GPM with a drawdown of ____ ft. after ____ hours of pumping

WELL DATA

Well Depth	Casing Diameter (In.)	Casing Length (Ft.)
397	2"	20 ft

Type of Casing	Hole Depth	Depth to Static Water Level
PVC	2"	43 ft.

TYPE OF COMPLETION: (Circle One or More): Gravel Packed, Underreamed, Telescoped, (Natural Development), Open Hole, Other (Describe) ____

Top of Lap Pipe or Reduction in Casing ____ FEET

IF TELESCOPED OR MORE THAN ONE SCREEN: USE BACK PAGE

LOG DATA

TYPE OF LOG RUN (Circle One): No Log Run, Electric, Gamma Ray, Density, Sonic, Neutron, Other (Describe) ____

Name of Organization Running Log: Bobby Beck's Well Works

GEOLOGIC DATA (Office Use Only)

Surface Elev.	Geologic Unit	Unit Thickness	Depth to Top
Subs. SWL	Date	Analysis	Aquifer Test

Driller's Remarks

SCREEN DATA

Diameter - Inches	Length - Feet	Slot Size - Inches
2"	20 ft	#8

Screen Type	Depth to Bottom - Feet
Johnson Screen	397

DESCRIPTION OF FORMATIONS ENCOUNTERED	FROM	TO

FORMATIONS ENCOUNTERED	FROM	TO
IF MORE SPACE IS NEEDED, USE BACK		

RECEIVED
MAY 15 1990
Department of Natural Resources
Bureau of Land & Water Resources

If well telescopes please
sketch and show depths.

GROUND LEVEL

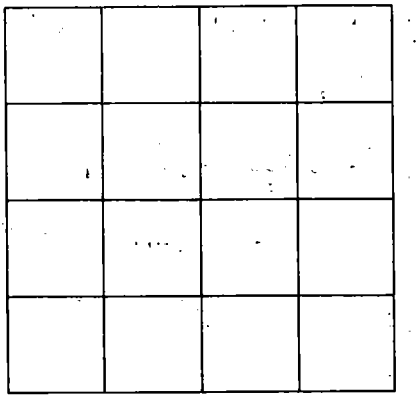

SECTION _____

Please indicate well location X.

ADDITIONAL INFORMATION

If more than one screen,
show location of each on sketch.