MISSISSIPPI DEPARTMENT OF ENVIRONMENTAL QUALITY
Bureau of Land and Water Resources

P. O. Box 10631
Jackson, MS 39289-0631
WATER WELL DRILLERS LOG

COUNTY WELL LOCATED: HARRISON	PERMIT NUMBER:
WELL NUMBER: K 2139 / COSED	NAME OF DRILLING FIRM: Coast Water Well Ser. Inc.
DATE WELL COMPLETED: 8-22-91	

NAME & MAILING ADDRESS OF LANDOWNER: Joe Howell

WELL LOCATION: SEC 11 TOWNSHIP 7 N (S) RANGE 12 E (W)

DISTANCE 3 Miles DIRECTION W of NEAREST TOWN ORANGE GROVE

OTHER LANDMARK:

WELL PURPOSE: (Home) Irrigation, Municipal, Industrial, Fish Pond, etc.

PUMP DATA

PUMP TYPE (Circle One): Submersible, Turbine, Jet, Flowing Well, Other (Describe) _____

POWER TYPE (Circle One): Electric, Tractor, Diesel, Gasoline, Butane, Other (Describe) _____ H/P _____

Pump Capacity (GPM)	No. of Stages	Setting Depth
		FT.

PUMP TEST

Well yielded _____ GPM with a drawdown of _____ ft. after _____ hours of pumping

WELL DATA

Well Depth	Casing Diameter (In.)	Casing Length (Ft.)
570'	2"	557
Type of Casing	**Hole Depth**	**Depth to Static Water Level**
PVC	570'	68'

TYPE OF COMPLETION: (Circle One or More): Gravel Packed, Underreamed, Telescoped, Natural Development, Open Hole, Other (Describe) _____

Top of Lap Pipe or Reduction in Casing: FEET

IF TELESCOPED OR MORE THAN ONE SCREEN: USE BACK PAGE

LOG DATA

TYPE OF LOG RUN (Circle One): (No Log Run), Electric, Gamma Ray, Density, Sonic, Neutron, Other (Describe) _____

Name of Organization Running Log:

GEOLOGIC DATA (Office Use Only)

Surface Elev.	Geologic Unit	Unit Thickness	Depth to Top
Subs. SWL	Date	Analysis	Aquifer Test

Driller's Remarks:

SCREEN DATA

Diameter - Inches	Length - Feet	Slot Size - Inches
2"	10'	.008
Screen Type	**Depth to Bottom - Feet**	
PVC	567	

DESCRIPTION OF FORMATIONS ENCOUNTERED	FROM	TO
Top soil	0	2
Gray Clay	2	10
Coarse sand/gravel	10	25
Blue Clay/S of Sand	25	185
Coarse Sand	185	230
Blue Clay/Shell	230	514
Coarse Sand	514	570

FORMATIONS (Continued)	FROM	TO

RECEIVED
OCT 09 1991
Dept. of Environmental Quality
Bureau of Land & Water Resources

IF MORE SPACE IS NEEDED, USE BACK

If well telescopes please
sketch and show depths.

GROUND LEVEL

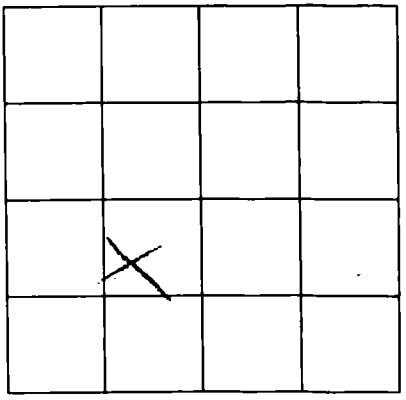

SECTION _____

Please indicate well location X.

ADDITIONAL INFORMATION

If more than one screen,
show location of each on sketch.