MISSISSIPPI DEPARTMENT OF ENVIRONMENTAL QUALITY
Office of Land and Water Resources

P. O. Box 10631
Jackson, MS 39289-0631
WATER WELL DRILLERS LOG

COUNTY WELL LOCATED: Harrison
WELL NUMBER: K 2207 CODED
DATE WELL COMPLETED: 11/28/95

PERMIT NUMBER: 0239
NAME OF DRILLING FIRM: McBill Pump & Well

NAME & MAILING ADDRESS OF LANDOWNER
Michael Naire
Placide rd.
Pass Christian MS.

WELL LOCATION. SEC 18 TOWNSHIP 7 N (S) RANGE 12 E (W)

DISTANCE 2 Miles DIRECTION North of NEAREST TOWN I-10

OTHER LANDMARK: Off Menge Ave

WELL PURPOSE (Home) Irrigation, Municipal, Industrial, Fish Pond, etc.

PUMP DATA

PUMP TYPE (Circle One): Submersible, Turbine, (Jet) Flowing Well, Other (Describe) _____

POWER TYPE (Circle One): (Electric) Tractor, Diesel, Gasoline, Butane, Other (Describe) _____ H/P 1

Pump Capacity (GPM)	No. of Stages	Setting Depth
10	2	100' FT.

PUMP TEST
Well yielded 10 GPM with a drawdown of 8' ft. after 12 hours of pumping

WELL DATA

Well Depth	Casing Diameter (In.)	Casing Length (Ft.)
400'	2"	380'

Type of Casing	Hole Depth	Depth to Static Water Level
PVC	400'	80'

TYPE OF COMPLETION: (Circle One or More): Gravel Packed, Underreamed, Telescoped, (Natural Development) Open Hole, Other (Describe) _____

WELL GROUTED TO A DEPTH OF 10 FEET
Type Grout (circle one): Cement, Bentonite, or Mix

LOG DATA

TYPE OF LOG RUN (Circle One): (No Log Run) Electric, Gamma Ray, Density, Sonic, Neutron, Other (Describe) _____

Name of Organization Running Log

GEOLOGIC DATA (Office Use Only)

Surface Elev.	Geologic Unit	Unit Thickness	Depth to Top
Subs. SWL	Date	Analysis	Aquifer Test

Driller's Remarks

Top of Lap Pipe or Reduction in Casing
FEET — IF TELESCOPED OR MORE THAN ONE SCREEN: USE BACK PAGE

SCREEN DATA

Diameter - Inches	Length - Feet	Slot Size - Inches
2"	20'	.0006

Screen Type	Depth to Bottom - Feet
PVC	400'

DESCRIPTION OF FORMATIONS ENCOUNTERED	FROM	TO
mud	0	60
sand	60	80
mud	80	240
sand	240	250
mud	250	360
sand	360	400

FORMATIONS (Continued)	FROM	TO

RECEIVED
JUN 30 1997
Dept. of Environmental Quality
Office of Land & Water Resources

IF MORE SPACE IS NEEDED, USE BACK

If well telescopes please
sketch and show depths.

GROUND LEVEL

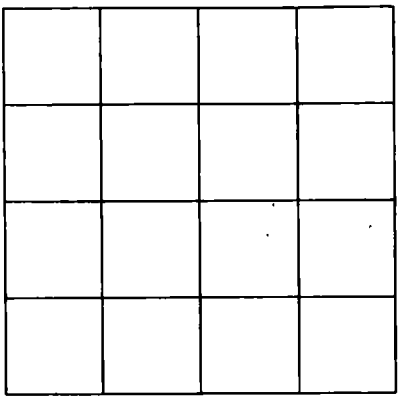

SECTION _____

Please indicate well location X.

ADDITIONAL INFORMATION

If more than one screen,
show location of each on sketch.