MISSISSIPPI DEPARTMENT OF ENVIRONMENTAL QUALITY
Office of Land and Water Resources

P. O. Box 10631
Jackson, MS 39289-0631

WATER WELL DRILLERS LOG

COUNTY WELL LOCATED	Harrison
WELL NUMBER	K-2240
CODED	
DATE WELL COMPLETED	2-16-01
PERMIT NUMBER	0-239
NAME OF DRILLING FIRM	mc Hill pump + well

NAME & MAILING ADDRESS OF LANDOWNER
Tony Russel
11476 whitemore pl.
Spt, ms 39503

WELL LOCATION	SEC	TOWNSHIP		RANGE	
	10	T	N S	12	E W

DISTANCE	DIRECTION	NEAREST TOWN
Miles	of	

OTHER LANDMARK

WELL PURPOSE: Irrigation, Municipal, Industrial, Fish Pond, etc.
home

PUMP DATA

PUMP TYPE (Circle One): Submersible, Turbine, (Jet) Flowing Well, Other (Describe)

POWER TYPE (Circle One): (Electric) Tractor, Diesel, Gasoline, Butane, Other (Describe) H/P 1

Pump Capacity (GPM)	No. of Stages	Setting Depth
10	2	60 FT.

PUMP TEST
Well yielded 10 GPM with a drawdown of 10 ft. after 5 hours of pumping

WELL DATA

Well Depth	Casing Diameter (In.)	Casing Length (Ft.)
580	2"	540

Type of Casing	Hole Depth	Depth to Static Water Level
PVC	580	40

TYPE OF COMPLETION: (Circle One or More): Gravel Packed, Underreamed, Telescoped, (Natural Development) Open Hole, Other (Describe)

WELL GROUTED TO A DEPTH OF 10 FEET
Type Grout (circle one): Cement, Bentonite, or Mix

LOG DATA

TYPE OF LOG RUN (Circle One): No Log Run, Electric, Gamma Ray, Density, Sonic, Neutron, Other (Describe)

Name of Organization Running Log

GEOLOGIC DATA (Office Use Only)

Surface Elev.	Geologic Unit	Unit Thickness	Depth to Top
Subs. SWL	Date	Analysis	Aquifer Test

Driller's Remarks

Top of Lap Pipe or Reduction in Casing
FEET — IF TELESCOPED OR MORE THAN ONE SCREEN: USE BACK PAGE

SCREEN DATA

Diameter - Inches	Length - Feet	Slot Size - Inches
2"	20	.006

Screen Type	Depth to Bottom - Feet
PVC	580

DESCRIPTION OF FORMATIONS ENCOUNTERED	FROM	TO	FORMATIONS (Continued)	FROM	TO
sand	0	60			
mud	60	200			
sand	200	220			
mud	220	560			
sand	560	580			
			IF MORE SPACE IS NEEDED, USE BACK		

RECD AUG 13 2001

If well telescopes please sketch and show depths.

GROUND LEVEL

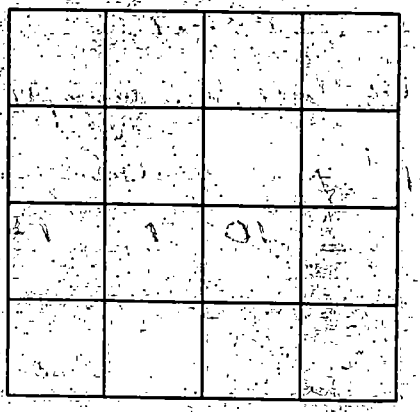

SECTION _____

Please indicate well location X.

ADDITIONAL INFORMATION

If more than one screen, show location of each on sketch.