MISSISSIPPI DEPARTMENT OF ENVIRONMENTAL QUALITY
Office of Land and Water Resources

P. O. Box 10631
Jackson, MS 39289-0631
WATER WELL DRILLERS LOG

COUNTY WELL LOCATED: Harrison	
WELL NUMBER: K-2241	CODED:
DATE WELL COMPLETED: 6-28-99	
PERMIT NUMBER: 0-239	
NAME OF DRILLING FIRM: McGill pump & well	

NAME & MAILING ADDRESS OF LANDOWNER: mense one.

Pass christian, MS 39571

WELL LOCATION	SEC	TOWNSHIP	RANGE
	15	7 N/S	12 E/W

DISTANCE	DIRECTION	NEAREST TOWN
Miles	of	

OTHER LANDMARK:

WELL PURPOSE (Home) Irrigation, Municipal, Industrial, Fish Pond, etc.: Home

PUMP DATA

PUMP TYPE (Circle One): (Submersible) Turbine, (Jet) Flowing Well, Other (Describe)

POWER TYPE (Circle One): (Electric) Tractor, Diesel, Gasoline, Butane, Other (Describe) H/P 1

Pump Capacity (GPM)	No of Stages	Setting Depth
20	10	100 FT.

PUMP TEST

Well yielded 20 GPM with a drawdown of 10 ft. after 10 hours of pumping

WELL DATA

Well Depth	Casing Diameter (In.)	Casing Length (Ft.)
520'	4x2	500
Type of Casing	**Hole Depth**	**Depth to Static Water Level**
PVC	520	480

TYPE OF COMPLETION: (Circle One or More): Gravel Packed, Underreamed, Telescoped, (Natural Development), Open Hole, Other (Describe)

WELL GROUTED TO A DEPTH OF 10 FEET
Type Grout (circle one): Cement, Bentonite, or Mix

LOG DATA

TYPE OF LOG RUN (Circle One): No Log Run, Electric, Gamma Ray, Density, Sonic, Neutron, Other (Describe) Write in Book

Name of Organization Running Log:

GEOLOGIC DATA (Office Use Only)

Surface Elev.	Geologic Unit	Unit Thickness	Depth to Top
Subs. SWL	Date	Analysis	Aquifer Test

Driller's Remarks:

Top of Lap Pipe or Reduction in Casing: FEET

IF TELESCOPED OR MORE THAN ONE SCREEN: USE BACK PAGE

SCREEN DATA

Diameter - Inches	Length - Feet	Slot Size - Inches
2"	20'	.006
Screen Type		**Depth to Bottom - Feet**
PVC		520

DESCRIPTION OF FORMATIONS ENCOUNTERED	FROM	TO	FORMATIONS (Continued)	FROM	TO
Sand	20	80			
mud	100	240			
mud	260	400			
mud	400	480			
Sand	500	520			
			IF MORE SPACE IS NEEDED, USE BACK		

RECD JUN 25 2001

If well telescopes please sketch and show depths.

GROUND LEVEL

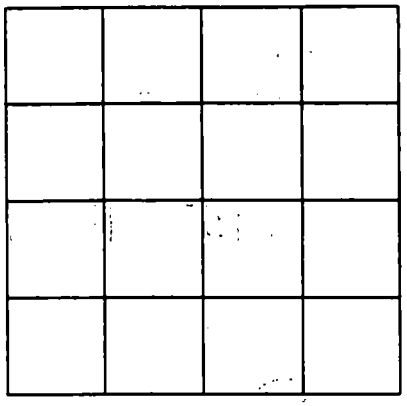

SECTION _____

Please indicate well location X.

ADDITIONAL INFORMATION

If more than one screen, show location of each on sketch.