Kim W. Lo[illegible] Rd on
[illegible] Rd

Harrison
L 35
4-68
BW 01597
CODED

MISSISSIPPI
BOARD OF WATER COMMISSIONERS
416 North State Street
Jackson, Mississippi 39201

CODED

WATER WELL DRILLERS LOG

4-19 1968 — date well completed
Switzer Well Co. — firm name
Harrison — county well located

LANDOWNER: Dedeaux & Plummer
522 Pass Road
Gulfport, Miss.
(mailing address)

WELL LOCATION:
sec. 12 T 7 S R 11 W
8 miles NE of GULFPORT
(distance) (direction) (nearest town)

WELL PURPOSE: Subdivision
(home, irrigation, municipal, industrial)

WELL COMPLETION DATA:

(1) diameter (inches) 8x6
(2) total depth (feet) 730
(3) static water level (feet) 8 below ~~above~~ top of ground.
(4) casing gal steel (material), 680' (depth),
8x6 (size) If telescope see back.
(5) screen 50' (length), 680' (depth to top)
8 ga (size), SS on pipe (material)
(6) pump 15 (HP) 250 (yield gpm)
electric (type power)
(7) electric log No (yes or no)
(organization running log)
(8) how well bottom plugged Back pressure valve

DRILLERS REMARKS:

description of formations encountered	from	to
sand	0	8
clay	8	21
sand	21	73
clay	73	100
mixed	100	105
clay	105	139
sand	139	147
mixed	147	179
clay	179	218
sand	218	232
clay	232	262
mixed	262	306
clay	306	328
shale	328	349
clay	349	372
mixed	372	459
shale	459	482
Fullers earth	482	526
mixed	526	571
fine sand	571	594
clay	594	617
mixed	617	639
shale + sand	639	661
good sand	661	728
fair sand	728	768

CODED

8 100

MISS. BD. OF WATER COMM.

If well telescopes please sketch and show depths.

GROUND LEVEL

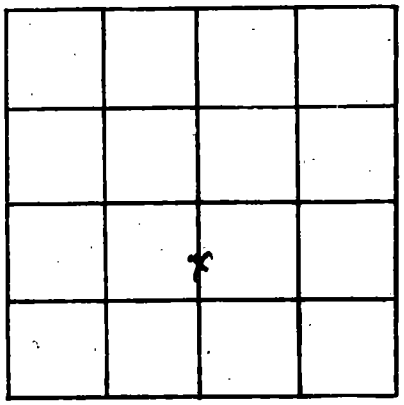

SECTION 12

Please indicate well location X.

ADDITIONAL INFORMATION

If more than one screen, show locations of each on sketch.