Harrison
L 216
3-28-69

MISSISSIPPI
BOARD OF WATER COMMISSIONERS
416 North State Street
Jackson, Mississippi 39201

CODED

WATER WELL DRILLERS LOG

3-28 1969 — date well completed
Switzer Well Co. — firm name
Harrison — county well located

LANDOWNER: Jack Green
Route 3 Box 526 B
Gulfport Miss
(mailing address)

WELL LOCATION:
sec. 5 T 7 S R 11 W
5 (distance) miles N (direction) of GULFPORT (nearest town)

WELL PURPOSE: Home
(home, irrigation, municipal, industrial)

WELL COMPLETION DATA:

(1) diameter (inches) 2
(2) total depth (feet) 540
(3) static water level (feet) 37 below ~~above~~ top of ground.
(4) casing gal. steel (material) 525' (depth), 2" (size) If telescope see back.
(5) screen 15' (length), 525' (depth to top), 8 ga (size), SS on pipe (material)
(6) pump 1 (HP) 350 gph (yield gpm), electric (type power)
(7) electric log No (yes or no)
(organization running log)
(8) how well bottom plugged Back pressure valve

DRILLERS REMARKS:

description of formations encountered	from	to
Mixed	0	41
Clay	41	84
Mixed	84	145
Fine sand	145	187
Sand	187	197
Fine clay	197	207
Clay	207	226
Mixed	226	269
Clay	269	308
Mixed	308	344
Clay	344	365
Mixed	365	384
Fine sand	384	406
Fine clay	406	416
Mixed	416	458
Fair sand	458	509
Good sand	509	547

SEP 19 1969
MISS. BD. OF WATER COMM.

If well telescopes please sketch and show depths.

GROUND LEVEL

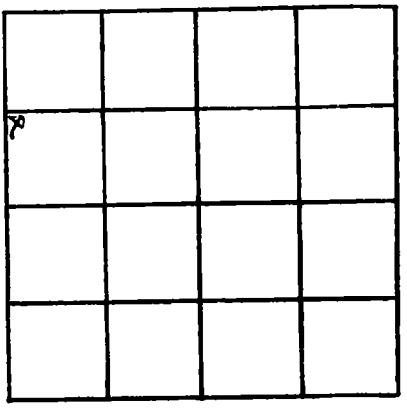

SECTION 5

Please indicate well location X.

ADDITIONAL INFORMATION

If more than one screen, show locations of each on sketch.