HARRISON
L329
5-24-71

MISSISSIPPI
BOARD OF WATER COMMISSIONERS
416 North State Street
Jackson, Mississippi 39201

CODED

WATER WELL DRILLERS LOG

5-24- 1971 — date well completed
Switzer Well Co. — firm name
Harrison — county well located

LANDOWNER: Standard Service Sta
Hwy 49
Gulfport, Miss.
(mailing address)

WELL LOCATION:
sec. 21 T 7 S R 11 W
2 miles N of Gulfport
(distance) (direction) (nearest town)

WELL PURPOSE: Service Station
(home, irrigation, municipal, industrial)

WELL COMPLETION DATA:

(1) diameter (inches) 4 x 2
(2) total depth (feet) 739'
(3) static water level (feet) -8 below / above top of ground.
(4) casing galv. (material), 739' (depth), 4" (size) If telescope see back.
(5) screen 20' (length), 719' (depth to top), 008 (size), stainless steel (material)
(6) pump 2 (HP) 25 (yield gpm) ELECT (type power)
(7) electric log No (yes or no)
(organization running log)
(8) how well bottom plugged back pressure valve

DRILLERS REMARKS:

description of formations encountered	from	to
clay	0	15
SAND, good	15	21
SAND	21	31
CLAY	31	58
SAND	58	61
CLAY	61	132
SAND	132	140
mixed	140	159
SAND, fine	159	179
SAND, fair	179	199
SAND	199	204
CLAY	204	327
SAND	327	332
CLAY	332	452
SAND	452	457
SAND, fine	457	471
CLAY	471	573
SAND	573	577
CLAY	577	638
CLAY + shell	638	657
CLAY	657	677
SAND, fair	677	697
SAND, good	697	738

CODED

JUN 23 1971

If well telescopes please sketch and show depths.

GROUND LEVEL

105' of 4" Galv.

414' of 2" Galv.

29' of 2" Stainless Steel Wire Wrapped Well Screen.

If more than one screen, show locations of each on sketch.

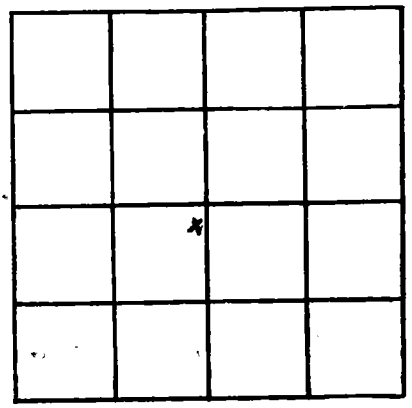

SECTION 21

Please indicate well location X.

ADDITIONAL INFORMATION