HARRISON
L330
5-27-71
6" D1596

MISSISSIPPI
BOARD OF WATER COMMISSIONERS
416 North State Street
Jackson, Mississippi 39201

CODED

WATER WELL DRILLERS LOG

5-27 1971 Switzer Well Co. Harrison
date well completed — firm name — county well located

LANDOWNER Loren D. Heights Subd.
522 Pass Rd.
Biloxi, Miss.
(mailing address)

WELL LOCATION:
sec. 12 T. 7 S R. 11 W
3 (distance) miles NW (direction) of Gulfport (nearest town)

WELL PURPOSE: SUBDIVISION
(home, irrigation, municipal, industrial)

WELL COMPLETION DATA:
(1) diameter (inches) 6"
(2) total depth (feet) 742'
(3) static water level (feet) 20' below ~~above~~ top of ground.
(4) casing black pipe (material) 742' (depth)
8" (size) If telescope see back.
(5) screen 63'6" (length), 678'6" (depth to top)
008 (size), Stainless steel (material)
(6) pump 20 (HP) 350 (yield gpm)
ELECT (type power)
(7) electric log NO (yes or no)
(organization running log)
(8) how well bottom plugged METAL
4" Backwash VALVE

DRILLERS REMARKS:

description of formations encountered	from	to
Clay	0	10
Sand	10	19
Mixed	19	39
Clay	39	95
Sand	95	103
Clay	103	143
Mixed	143	153
Clay	153	261
Sand, fair	261	282
Sand, good	282	297
Clay	297	400
Sand	400	403
Clay	403	460
Sand	460	465
Clay	465	498
Sand	498	512
Clay	512	616
Sand	616	618
Clay	618	657
Sand	657	742

CODED

JUN 23 1971

If well telescopes please sketch and show depths.

GROUND LEVEL

218' to 198'

194' to 179'

63 ft. of 6" STAINLESS STEEL WIRE WRAPPED WELL SCREEN

If more than one screen, show locations of each on sketch.

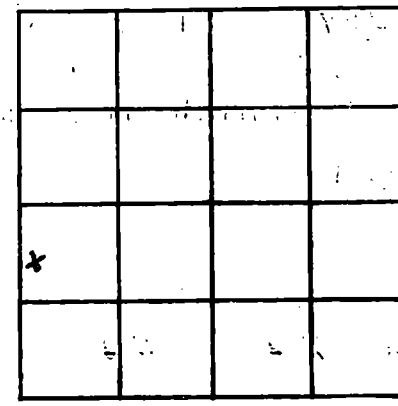

SECTION 12

Please indicate well location X.

ADDITIONAL INFORMATION