HARRISON
L 358
10-11-72

MISSISSIPPI
BOARD OF WATER COMMISSIONERS
416 North State Street
Jackson, Mississippi 39201

CODED

WATER WELL DRILLERS LOG

Oct. 11 1972 McGill well works Harrison
date well completed — firm name — county well located

LANDOWNER: Elizabeth Baum
Rt. 5, Box 689 Gulfport
(mailing address)

WELL LOCATION:
sec. 31 T 2 N/S R 11 E/W
3 miles (distance) SW (direction) of Woolmarket (nearest town)

WELL PURPOSE: home
(home, irrigation, municipal, industrial)

WELL COMPLETION DATA:

(1) diameter (inches) 2"
(2) total depth (feet) 452'
(3) static water level (feet) 28' ~~below~~ above top of ground.
(4) casing gal (material), 242' (depth),
— (size) if telescope see back.
(5) screen 10' (length), (depth to top)
2 (size), S.S. (material)
(6) pump 1 (HP) ? (yield gpm)
electric (type power)
(7) electric log no (yes or no)
— (organization running log)
(8) how well bottom plugged Sand Shark.

DRILLERS REMARKS:

description of formations encountered	from	to
Clay	0	18
Coarse sand	18	69
Clay	69	178
slush	178	210
fine sand	210	263
& clay	263	307
sand	307	332
Blue clay	332	418
sand	418	452

If well telescopes please sketch and show depths.

GROUND LEVEL

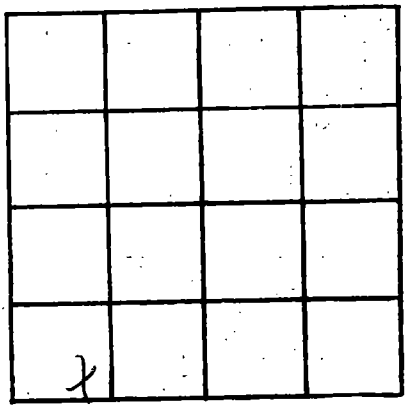

SECTION 31

Please indicate well location X.

ADDITIONAL INFORMATION

If more than one screen, show locations of each on sketch.