HARRISON
L 483
4-23-76

MISSISSIPPI
BOARD OF WATER COMMISSIONERS
416 North State Street
Jackson, Mississippi 39201

CODED

WATER WELL DRILLERS LOG

4-23- 1976 McGill Well Works Inc. Harrison
date well completed — firm name — county well located

LANDOWNER: Mr. Shoemaker
129 Woodglen Drive
Gulf, Ms.
(mailing address)

WELL LOCATION:
sec. 27 T. 7 (N) (S) R. 11 (E) (W)
1 miles NE of Gulfport
(distance) (direction) (nearest town)

WELL PURPOSE: Lawn
(home, irrigation, municipal, industrial)

WELL COMPLETION DATA:
(1) diameter (inches) 2"
(2) total depth (feet) 30'
(3) static water level (feet) 4' below above top of ground.
(4) casing Sch 40 plastic, 20
(material), (depth)
(size) If telescope see back.
(5) screen 10', (length), (depth to top)
2", (size), plastic (material)
(6) pump 1/2 (HP) 12 (yield gpm)
Electric (type power)
(7) electric log — (yes or no)
(organization running log)
(8) how well bottom plugged capped

DRILLERS REMARKS:

description of formations encountered	from	to
Sand Gravel	0	30

CODED

RECEIVED
AUG 16 1976
MISS. BD. OF WATER COMM.

If well telescopes please sketch and show depths.

GROUND LEVEL

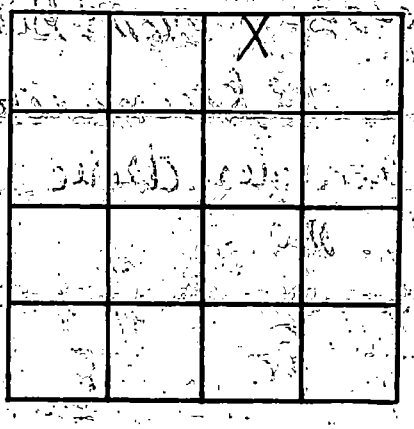

SECTION 27

Please indicate well location X.

ADDITIONAL INFORMATION

If more than one screen, show locations of each on sketch.