HAR.
L 2022
4-1-64

MISSISSIPPI BOARD OF WATER COMMISSIONERS

WATER WELL DRILLERS LOG

Date: Apr 1, 1964, Driller: Joe Miller (Name) County Harrison

(1) Owner of Land: Brewer (Name)

Courtesy add. Orange Grove Cotton (Address)

(2) Location: ___ ¼, ___ ¼, Sec. ___ T 7 R 11,

5 miles North (direction), of Gulfport (Nearest Town), (distance)

(3) Topography: Hilly (Hilly) (Flat) (Level)

(4) Purpose of Well: Domestic (Domestic Irrigation Municipal, Industrial, Other)

Information upon completion of well:

(1) Diameter 2" inches.

(2) Total Depth 423 feet.

(3) Water Level 24' feet below top of ground.

(4) Cased to 408, Size 2",

(5) Screen: Size 2", Length 10'.

(6) Were any formations sealed against pollution?

___ yes, ___ no.

If YES depth of formation ___,

Why ___

Drillers Remarks: ___

Description & Color of Materials Sand, Clay, Red Clay, Shell, etc.	Thickness Feet	Depth Feet
Surface	8	8
Coarse Fan Sand.	10	18
Pink + Brown Clay	9	27
Brown Clay	8	35
White Clay	7	42
Blue Clay	6	48
Gray Clay	7	55
Red Clay + Red Sand	9	64
" " " "	6	70
White Clay	36	106
Fan Sand & Fine	22	128
White Clay	7	135
Hard Blue Clay	73	208
Sand. No.	4	212
Hard Blue Clay.	78	390
Gray Sand. Fan	10	400
" " Good	11	411
" " "	7	418
" " Finer	9	427
10' Just Pipe.		

RECEIVED DEC 14 1964 MISS. BOARD OF WATER COMM.

(Use Back Side)

Well No.

Mail this copy to Board of Water Commissioners 429 Miss. St. Jackson, Miss.

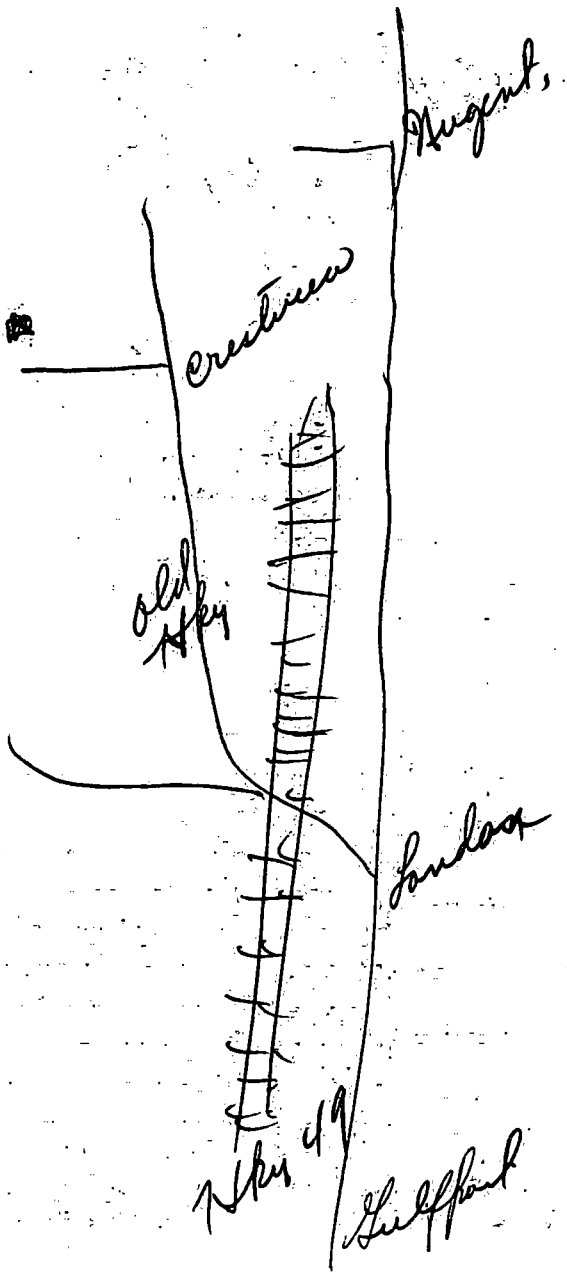
Crestview
old Hwy
London
Hwy 49
