Harrison
L
2074

MISSISSIPPI DEPARTMENT OF NATURAL RESOURCES
Bureau of Land and Water Resources
Southport Mall
P.O. Box 10631
Jackson, Mississippi 39209
WATER WELL DRILLERS LOG

6-24 1983 McGuire Wells, Inc Harrison
date well completed — firm name — county well located

LANDOWNER: McGuire Homes
1115 Pass Road
Gpt., Ms 39501
(mailing address)

WELL LOCATION:
sec. 35 T 7 N (S) R 11 E (W)
0 (distance) miles 0 (direction) of Gulf Port (nearest town)
Bond Road

WELL PURPOSE: Home
(home, irrigation, municipal, industrial)

WELL COMPLETION DATA:
(1) diameter (inches) 2"
(2) total depth (feet) 400'
(3) static water level (feet) 65' below above top of ground.
(4) casing 40 PVC, 390 ~~[illegible]~~
(material), (depth)
(size) if telescope see back.
(5) screen 10', 390'
(length), (depth to top)
2", 80 PVC 6 slot
(size), (material)
(6) pump 1 (HP) 10 (yield gpm)
electric
(type power)
(7) electric log NO
(yes or no)
(organization running log)
(8) how well bottom plugged Sand Seal

DRILLERS REMARKS:

description of formations encountered	from	to

DEPT. OF NATURAL RESOURCES
BUREAU OF LAND & WATER RESOURCES
AUG 10 1983
RECEIVED

If well telescopes please sketch and show depths.

GROUND LEVEL

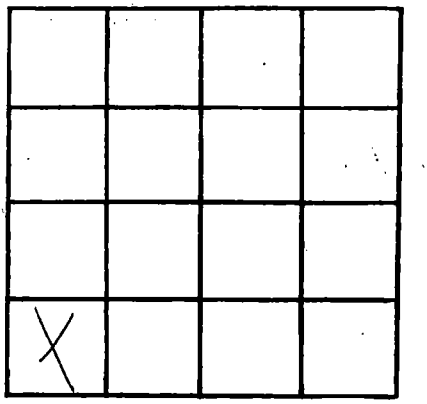

SECTION 35

Please indicate well location X.

ADDITIONAL INFORMATION

If more than one screen, show locations of each on sketch.