HARRISON
L
2091

MISSISSIPPI DEPARTMENT OF NATURAL RESOURCES

Bureau of Land and Water Resources
Southport Mall
P.O. Box 10631
Jackson, Mississippi 39209

WATER WELL DRILLERS LOG

6-10 1985 McGill Pump & Well Harrison
date well completed firm name county well located

LANDOWNER: Edgar A Guevas
2900 - 40th Ave.
Gulfport Ms. 39503
(mailing address)

WELL LOCATION:
sec. 14 T 36 N (S) R 12 E (W)
3 miles NW of Gulfport
(distance) (direction) (nearest town)

WELL PURPOSE:
(home, irrigation, municipal, industrial)

WELL COMPLETION DATA:

(1) diameter (inches) 2"

(2) total depth (feet) 30'

(3) static water level (feet) 5' below above top of ground.

(4) casing Sch 40 PVC (material), 20' (depth),
(size) If telescope see back.

(5) screen 10' (length), 20' (depth to top)
2" (size), Sch. 80 - 6 slot (material)

(6) pump 1/2 (HP) 15 (yield gpm)
Elec. (type power)

(7) electric log (yes or no)
(organization running log)

(8) how well bottom plugged sand
shank

DRILLERS REMARKS:

description of formations encountered	from	to
Sand	0	30

RECEIVED
JUL 8 - 1985
Department of Natural Resources
Bureau of Land & Water Resources

If well telescopes please sketch and show depths.

GROUND LEVEL

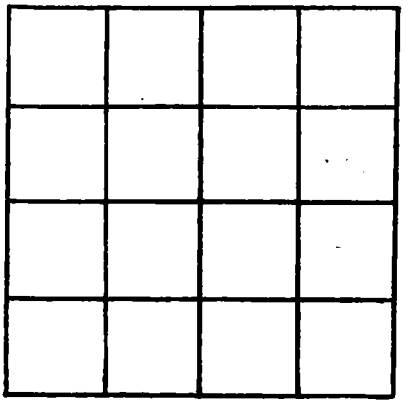

SECTION _____

Please indicate well location X.

ADDITIONAL INFORMATION

If more than one screen, show locations of each on sketch.