MISSISSIPPI DEPARTMENT OF NATURAL RESOURCES

Bureau of Land and Water Resources

P.O. Box 10631
Jackson, Mississippi 39209

WATER WELL DRILLERS LOG

COUNTY WELL LOCATED: HARRISON	PERMIT NUMBER: Braden Pump & Well Service, Inc.
WELL NUMBER: L 21/20 — CODED	NAME OF DRILLING FIRM: 17170 Country Cove, Saucier, MS 39574
DATE WELL COMPLETED: 6-24-87	Mr B Drilling Co.

NAME & MAILING ADDRESS OF LANDOWNER

DAVID WARDEN
Rt 11 Box 66
Gulfport MS 39503

WELL LOCATION: SEC 8 TOWNSHIP 7 S RANGE 11 W

DISTANCE 1 Miles **DIRECTION** NW of **NEAREST TOWN** Landon

OTHER LANDMARK

WELL PURPOSE: Home, Irrigation, Municipal, Industrial, Fish Pond, etc.
Home

PUMP DATA

PUMP TYPE (Circle One): Submersible, Turbine, (Jet) Flowing Well, Other (Describe) _____

POWER TYPE (Circle One): (Electric) Tractor, Diesel, Gasoline, Butane, Other (Describe) _____

Pump Capacity (GPM)	No. of Stages	Setting Depth
10	2	50 FT.

PUMP TEST

Well yielded _____ GPM with a drawdown of _____ ft. after _____ hours of pumping

WELL DATA

Well Depth	Casing Diameter (In.)	Casing Length (Ft.)
270'	2"	2 ft 6'

Type of Casing	Hole Depth	Depth to Static Water Level
PVC	260	32

TYPE OF COMPLETION: (Circle One or More): Gravel Packed, Underreamed, Telescoped, (Natural Development), Open Hole, Other (Describe) _____

Top of Lap Pipe or Reduction in Casing FEET

IF TELESCOPED OR MORE THAN ONE SCREEN: USE BACK PAGE

LOG DATA

TYPE OF LOG RUN (Circle One): (No Log Run) Electric, Gamma Ray, Density, Sonic, Neutron, Other (Describe) _____

Name of Organization Running Log

GEOLOGIC DATA (Office Use Only)

Surface Elev.	Geologic Unit	Unit Thickness	Depth to Top
Subs. SWL	Date	Analysis	Aquifer Test

Driller's Remarks

SCREEN DATA

Diameter - Inches	Length - Feet	Slot Size - Inches
2"	10	.008

Screen Type	Depth to Bottom - Feet
PVC-WOP	255 - 5 ft Tail pipe

RECEIVED
AUG 14 1987
Department of Natural Resources
Bureau of Land & Water Resources

DESCRIPTION OF FORMATIONS ENCOUNTERED	FROM	TO	FORMATIONS (Continued)	FROM	TO
Surface	0	8			
Red Sand	8	40			
White Clay	40	70			
White Sand	70	100			
Clay	100	150			
Grey Sand & Clay	150	210			
Sharp Sand	210	255			
Blue Clay	255	260	+		

IF MORE SPACE IS NEEDED, USE BACK

If well telescopes please sketch and show depths.

GROUND LEVEL

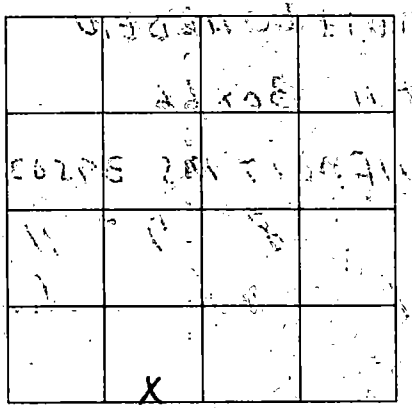

SECTION 8

Please indicate well location X.

ADDITIONAL INFORMATION

If more than one screen, show location of each on sketch.