MISSISSIPPI DEPARTMENT OF NATURAL RESOURCES

Bureau of Land and Water Resources

P.O. Box 10631
Jackson, Mississippi 39209

WATER WELL DRILLERS LOG

COUNTY WELL LOCATED: Harrison	
WELL NUMBER: L 2129	CODED
DATE WELL COMPLETED: 2/10/88	
PERMIT NUMBER: 0239	
NAME OF DRILLING FIRM: McGill Pump & Wells	

NAME & MAILING ADDRESS OF LANDOWNER
Dennis Dauro
P.O. Box 657
Long Beach Ms.

WELL LOCATION: SEC 18 TOWNSHIP 7 N (S) RANGE 11 E (W)

DISTANCE 2 Miles DIRECTION West of NEAREST TOWN Lpt.

OTHER LANDMARK

WELL PURPOSE: Home, Irrigation, Municipal, Industrial, Fish Pond, etc.
Business

PUMP DATA

PUMP TYPE (Circle One): (Submersible), Turbine, Jet, Flowing Well, Other (Describe)

POWER TYPE (Circle One): (Electric), Tractor, Diesel, Gasoline, Butane, Other (Describe)

Pump Capacity (GPM)	No. of Stages	Setting Depth
25	6	80' FT.

PUMP TEST

Well yielded 25 GPM with a drawdown of 20 ft. after 1 hours of pumping

WELL DATA

Well Depth	Casing Diameter (In.)	Casing Length (Ft.)
580'	4"/2"	580'

Type of Casing	Hole Depth	Depth to Static Water Level
PVC	580	20'

TYPE OF COMPLETION: (Circle One or More): Gravel Packed, Underreamed, Telescoped, (Natural Development), Open Hole, Other (Describe)

Top of Lap Pipe or Reduction in Casing FEET

IF TELESCOPED OR MORE THAN ONE SCREEN: USE BACK PAGE

SCREEN DATA

Diameter - Inches	Length - Feet	Slot Size - Inches
2"	20'	.00060

Screen Type	Depth to Bottom - Feet
PVC	580'

LOG DATA

TYPE OF LOG RUN (Circle One): (No Log Run), Electric, Gamma Ray, Density, Sonic, Neutron, Other (Describe)

Name of Organization Running Log

GEOLOGIC DATA (Office Use Only)

Surface Elev.	Geologic Unit	Unit Thickness	Depth to Top
Subs. SWL	Date	Analysis	Aquifer Test

Driller's Remarks

RECEIVED
APR 15 1988
Department of Natural Resources
Bureau of Land & Water Resources

DESCRIPTION OF FORMATIONS ENCOUNTERED	FROM	TO	FORMATIONS (Continued)	FROM	TO
mud	0	80			
Sand	80	120			
mud	120	420			
Sand	420	440			
mud	440	520			
Sand	520	580			

IF MORE SPACE IS NEEDED, USE BACK

If well telescopes please sketch and show depths.

GROUND LEVEL

180' = 4" TOP

400' = 2" Bottom

If more than one screen, show location of each on sketch.

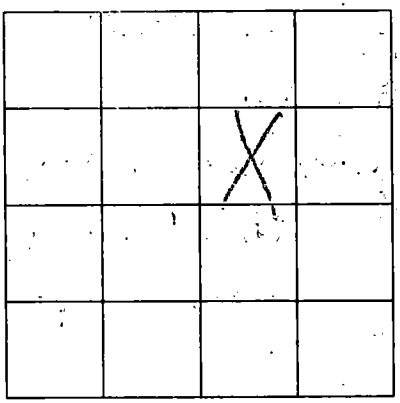

SECTION _____

Please indicate well location X.

ADDITIONAL INFORMATION