MISSISSIPPI DEPARTMENT OF NATURAL RESOURCES

Bureau of Land and Water Resources

P.O. Box 10631
Jackson, Mississippi 39209

WATER WELL DRILLERS LOG

COUNTY WELL LOCATED	Harrison
WELL NUMBER	L-2149
CODED	
DATE WELL COMPLETED	5-10-90
PERMIT NUMBER	O-039
NAME OF DRILLING FIRM	McGill

NAME & MAILING ADDRESS OF LANDOWNER
Roy Leslie
W. Echo Hills
Gulf., Ms. 39503

WELL LOCATION: SEC 6 TOWNSHIP 7 N/S RANGE 11 E/W

DISTANCE 3 Miles DIRECTION N of NEAREST TOWN Gulf

OTHER LANDMARK Robbinson Rd.

WELL PURPOSE: Home, Irrigation, Municipal, Industrial, Fish Pond, etc.

PUMP DATA

PUMP TYPE (Circle One): Submersible, Turbine, Jet, Flowing Well, Other (Describe) _____

POWER TYPE (Circle One): Electric, Tractor, Diesel, Gasoline, Butane, Other (Describe) _____

Pump Capacity (GPM)	No. of Stages	Setting Depth
18	14	FT.

PUMP TEST

Well yielded _____ GPM with a drawdown of _____ ft. after 1 hours of pumping

WELL DATA

Well Depth	Casing Diameter (In.)	Casing Length (Ft.)
520'	4x2	500

Type of Casing	Hole Depth	Depth to Static Water Level
PVC	520'	

TYPE OF COMPLETION: (Circle One or More): Gravel Packed, Underreamed, Telescoped, Natural Development, Open Hole, Other (Describe) _____

Top of Lap Pipe or Reduction in Casing FEET

IF TELESCOPED OR MORE THAN ONE SCREEN: USE BACK PAGE

LOG DATA

TYPE OF LOG RUN (Circle One): No Log Run, Electric, Gamma Ray, Density, Sonic, Neutron, Other (Describe) _____

Name of Organization Running Log

GEOLOGIC DATA (Office Use Only)

Surface Elev.	Geologic Unit	Unit Thickness	Depth to Top
Subs. SWL	Date	Analysis	Aquifer Test

Driller's Remarks

SCREEN DATA

Diameter - Inches	Length - Feet	Slot Size - Inches
2"	20'	.0006

Screen Type	Depth to Bottom - Feet
SCH 40 PVC	520'

DESCRIPTION OF FORMATIONS ENCOUNTERED	FROM	TO
MUD, SAND	0	40
MUD	40	180
SAND	180	200
MUD	200	440
MUD, SAND	440	480
SAND	480	520

FORMATIONS (Continued)	FROM	TO

RECEIVED
AUG 24 1990
Department of Natural Resources
Bureau of Land & Water Resources

IF MORE SPACE IS NEEDED, USE BACK

If well telescopes please
sketch and show depths.

GROUND LEVEL

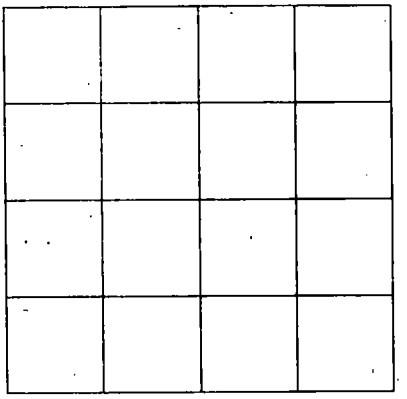

SECTION _____

Please indicate well location X.

ADDITIONAL INFORMATION

If more than one screen,
show location of each on sketch.