MISSISSIPPI DEPARTMENT OF ENVIRONMENTAL QUALITY
Bureau of Land and Water Resources

P. O. Box 10631
Jackson, MS 39289-0631
WATER WELL DRILLERS LOG

COUNTY WELL LOCATED	Harrison
WELL NUMBER	L-216
CODED	
DATE WELL COMPLETED	4-25-90
PERMIT NUMBER	
NAME OF DRILLING CO.	Coastal Drilling & Service Co. 8456 Woolmarket Biloxi Road Biloxi, Mississippi 39532

NAME & MAILING ADDRESS OF LANDOWNER: Jane Ann Gill, 378 Hghy 49, Saucier, Ms

WELL LOCATION: Harrison — SEC 9 — TOWNSHIP 7 N (S) — RANGE 11 E (W)

DISTANCE 1 Miles — DIRECTION NW — of NEAREST TOWN Saucier

OTHER LANDMARK: Ms Powerline

WELL PURPOSE: Home, Irrigation, Municipal, Industrial, Fish Pond, etc.

PUMP DATA

PUMP TYPE (Circle One): Submersible, Turbine, (Jet) Flowing Well, Other (Describe) _____

POWER TYPE (Circle One): (Electric) Tractor, Diesel, Gasoline, Butane, Other (Describe) _____ H/P _____

Pump Capacity (GPM)	No. of Stages	Setting Depth
10	2	80 FT.

PUMP TEST

Well yielded 10 GPM with a drawdown of 0 ft. after 5 hours of pumping

WELL DATA

Well Depth	Casing Diameter (In.)	Casing Length (Ft.)
430'	2"	420'

Type of Casing	Hole Depth	Depth to Static Water Level
PVC	430'	60'

TYPE OF COMPLETION: (Circle One or More): Gravel Packed, Underreamed, Telescoped, (Natural Development), Open Hole, Other (Describe) _____

Top of Lap Pipe or Reduction in Casing: FEET — IF TELESCOPED OR MORE THAN ONE SCREEN: USE BACK PAGE

LOG DATA

TYPE OF LOG RUN (Circle One): No Log Run, Electric, Gamma Ray, Density, Sonic, Neutron, Other (Describe) _____

Name of Organization Running Log

GEOLOGIC DATA (Office Use Only)

Surface Elev.	Geologic Unit	Unit Thickness	Depth to Top
Subs. SWL	Date	Analysis	Aquifer Test

Driller's Remarks: None

SCREEN DATA

Diameter - Inches	Length - Feet	Slot Size - Inches
2"	10	.008

Screen Type	Depth to Bottom - Feet
PVC	430'

DESCRIPTION OF FORMATIONS ENCOUNTERED	FROM	TO
top soil	1'	3'
Red sand	3'	12'
White sand	12'	18'
soft Blue clay	18'	95'
Hard Blue clay	95'	220'
fine water sand	220	260'
Hard Blue clay	260'	390'
fine water sand	390'	410'
Coarse water sand	410'	430'

FORMATIONS ENCOUNTERED (CONTINUED)	FROM	TO

IF MORE SPACE IS NEEDED, USE BACK

RECEIVED
MAR 12 1992
Dept. of Environmental Quality
Bureau of Land & Water Resources

If well telescopes please
sketch and show depths.

GROUND LEVEL

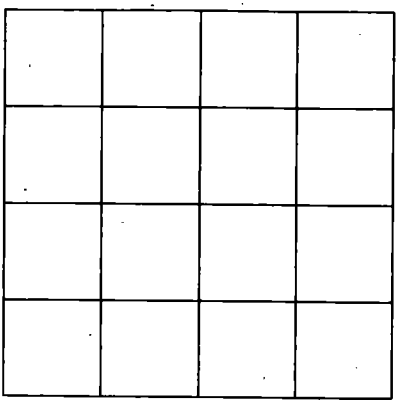

SECTION _____

Please indicate well location X.

ADDITIONAL INFORMATION

RECEIVED
Dept. of Environmental Quality
Bureau of Land & Water Resources

If more than one screen,
show location of each on sketch.