MISSISSIPPI DEPARTMENT OF ENVIRONMENTAL QUALITY
Office of Land and Water Resources

P. O. Box 10631
Jackson, MS 39289-0631

WATER WELL DRILLERS LOG

COUNTY WELL LOCATED	Harrison
WELL NUMBER	L 2192
CODED	
DATE WELL COMPLETED	7-10-95
PERMIT NUMBER	0-239
NAME OF DRILLING FIRM	McGill

NAME & MAILING ADDRESS OF LANDOWNER
Joseph Alphonso
#64 53rd St.
Gulfport, Ms. 39507

WELL LOCATION	SEC	TOWNSHIP	RANGE
	24	7 (N)	11 (E) (W)

DISTANCE	DIRECTION	NEAREST TOWN
2 Miles	East	of Gpt.

OTHER LANDMARK

WELL PURPOSE: Home, Irrigation, Municipal, Industrial, Fish Pond, etc.

PUMP DATA

PUMP TYPE (Circle One): Submersible, Turbine, Jet, Flowing Well, Other (Describe)

POWER TYPE (Circle One): Electric, Tractor, Diesel, Gasoline, Butane, Other (Describe) H/P 1

Pump Capacity (GPM)	No. of Stages	Setting Depth
10	2	30' FT.

PUMP TEST

Well yielded 12 GPM with a drawdown of 10 ft. after 12 hours of pumping

WELL DATA

Well Depth	Casing Diameter (In.)	Casing Length (Ft.)
240	2"	220

Type of Casing	Hole Depth	Depth to Static Water Level
PVC	240	10'

TYPE OF COMPLETION: (Circle One or More): Gravel Packed, Underreamed, Telescoped, Natural Development, Open Hole, Other (Describe)

WELL GROUTED TO A DEPTH OF 10 FEET
Type Grout (circle one): Cement, Bentonite, or Mix

LOG DATA

TYPE OF LOG RUN (Circle One): No Log Run, Electric, Gamma Ray, Density, Sonic, Neutron, Other (Describe)

Name of Organization Running Log

GEOLOGIC DATA (Office Use Only)

Surface Elev.	Geologic Unit	Unit Thickness	Depth to Top
Subs. SWL	Date	Analysis	Aquifer Test

Driller's Remarks

Top of Lap Pipe or Reduction in Casing FEET

IF TELESCOPED OR MORE THAN ONE SCREEN: USE BACK PAGE

SCREEN DATA

Diameter - Inches	Length - Feet	Slot Size - Inches
2"	20'	0006

Screen Type	Depth to Bottom - Feet
PVC	220

DESCRIPTION OF FORMATIONS ENCOUNTERED	FROM	TO
mud	0	60
Sand	60	80
mud	80	200
Sand	200	240

FORMATIONS (Continued)	FROM	TO

NOV 0 4 1995
Dept. of Environmental Quality
Office of Land and Water Resources

IF MORE SPACE IS NEEDED USE BACK

If well telescopes please
sketch and show depths.

GROUND LEVEL

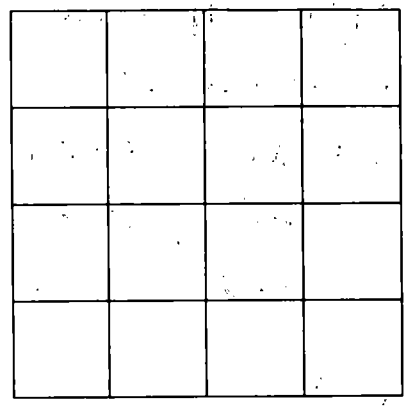

SECTION _____

Please indicate well location X.

ADDITIONAL INFORMATION

If more than one screen,
show location of each on sketch.