MISSISSIPPI DEPARTMENT OF ENVIRONMENTAL QUALITY
Office of Land and Water Resources

P. O. Box 10631
Jackson, MS 39289-0631
WATER WELL DRILLERS LOG

COUNTY WELL LOCATED: Harrison	PERMIT NUMBER: 0404
WELL NUMBER: L 2201 CODED	NAME OF DRILLING FIRM: Lyman Well Co
DATE WELL COMPLETED: 10-24-97	Gpt, MS, 39503

NAME & MAILING ADDRESS OF LANDOWNER: Compression Coat Inc. Seaway Rd Gulfport ms 39503

WELL LOCATION: SEC 15 TOWNSHIP 7 N/S RANGE 11 E/W

DISTANCE ____ Miles DIRECTION ____ of NEAREST TOWN ____

OTHER LANDMARK

WELL PURPOSE: Home, Irrigation, Municipal, Industrial, Fish Pond, etc.

PUMP DATA

PUMP TYPE (Circle One): Submersible, Turbine, Jet, Flowing Well, Other (Describe) ____

POWER TYPE (Circle One): Electric, Tractor, Diesel, Gasoline, Butane, Other (Describe) ____ H/P ____

Pump Capacity (GPM)	No. of Stages	Setting Depth
		FT.

PUMP TEST

Well yielded ____ GPM with a drawdown of ____ ft. after ____ hours of pumping

WELL DATA

Well Depth	Casing Diameter (In.)	Casing Length (Ft.)
120'	2"	

Type of Casing	Hole Depth	Depth to Static Water Level
PVC		

TYPE OF COMPLETION: (Circle One or More): Gravel Packed, Underreamed, Telescoped, Natural Development, Open Hole, Other (Describe) ____

WELL GROUTED TO A DEPTH OF ____ FEET
Type Grout (circle one): Cement, Bentonite, or Mix

LOG DATA

TYPE OF LOG RUN (Circle One): No Log Run, Electric, Gamma Ray, Density, Sonic, Neutron, Other (Describe) ____

Name of Organization Running Log

GEOLOGIC DATA (Office Use Only)

Surface Elev.	Geologic Unit	Unit Thickness	Depth to Top
Subs. SWL	Date	Analysis	Aquifer Test

Driller's Remarks

SCREEN DATA

Diameter - Inches	Length - Feet	Slot Size - Inches
2"	10'	.008

Screen Type	Depth to Bottom - Feet
PVC	

Top of Lap Pipe or Reduction in Casing FEET

IF TELESCOPED OR MORE THAN ONE SCREEN: USE BACK PAGE

DESCRIPTION OF FORMATIONS ENCOUNTERED	FROM	TO	FORMATIONS (Continued)	FROM	TO

IF MORE SPACE IS NEEDED, USE BACK

RECEIVED
DEC 08 1997
Dept. of Environmental Quality
Office of Land & Water Resources

If well telescopes please
sketch and show depths.

GROUND LEVEL

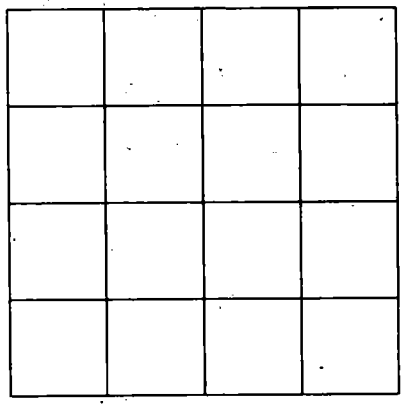

SECTION _____

Please indicate well location X.

ADDITIONAL INFORMATION

If more than one screen,
show location of each on sketch.