MISSISSIPPI DEPARTMENT OF ENVIRONMENTAL QUALITY
Office of Land and Water Resources

P. O. Box 10631
Jackson, MS 39289-0631
WATER WELL DRILLERS LOG

COUNTY WELL LOCATED	Harrison
WELL NUMBER	L-2209
CODED	
DATE WELL COMPLETED	7-24-99
PERMIT NUMBER	0-239
NAME OF DRILLING FIRM	mc Hal pump well

NAME & MAILING ADDRESS OF LANDOWNER

Court House.
Gulfport MS 39503

WELL LOCATION: SEC 1 TOWNSHIP 8 N/S RANGE 11 E/W

DISTANCE ____ Miles DIRECTION ____ of NEAREST TOWN ____

OTHER LANDMARK

WELL PURPOSE: (Home) Irrigation, Municipal, Industrial, Fish Pond, etc.

PUMP DATA

PUMP TYPE (Circle One): Submersible, Turbine, (Jet) Flowing Well, Other (Describe) ____

POWER TYPE (Circle One): (Electric) Tractor, Diesel, Gasoline, Butane, Other (Describe) ____ H/P 1

Pump Capacity (GPM)	No. of Stages	Setting Depth
10	2	70 FT.

PUMP TEST

Well yielded 10 GPM with a drawdown of 5 ft. after 5 hours of pumping

WELL DATA

Well Depth	Casing Diameter (In.)	Casing Length (Ft.)
260	2"	240

Type of Casing	Hole Depth	Depth to Static Water Level
PVC	260	220

TYPE OF COMPLETION: (Circle One or More): Gravel Packed, Underreamed, Telescoped, (Natural Development), Open Hole, Other (Describe) ____

WELL GROUTED TO A DEPTH OF 10 FEET
Type Grout (circle one): Cement, Bentonite, or Mix

LOG DATA

TYPE OF LOG RUN (Circle One): No Log Run, Electric, Gamma Ray, Density, Sonic, Neutron, Other (Describe) hand written

Name of Organization Running Log

GEOLOGIC DATA (Office Use Only)

Surface Elev.	Geologic Unit	Unit Thickness	Depth to Top
Subs. SWL	Date	Analysis	Aquifer Test

Driller's Remarks

Top of Lap Pipe or Reduction in Casing FEET

IF TELESCOPED OR MORE THAN ONE SCREEN: USE BACK PAGE

SCREEN DATA

Diameter - Inches	Length - Feet	Slot Size - Inches
2"	20	.006

Screen Type	Depth to Bottom - Feet
PVC	260

DESCRIPTION OF FORMATIONS ENCOUNTERED	FROM	TO
mud	20	40
Sand	40	80
mud	80	200
Sand	200	260

FORMATIONS (Continued)	FROM	TO

IF MORE SPACE IS NEEDED, USE BACK

REC'D JUN 25 2001

If well telescopes please sketch and show depths.

GROUND LEVEL

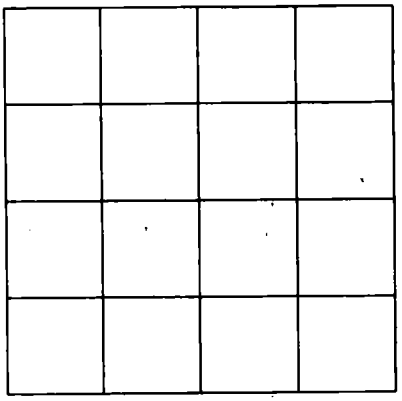

SECTION _____

Please indicate well location X.

ADDITIONAL INFORMATION

If more than one screen, show location of each on sketch.