

M 173

3-28-63

WATER WELL DRILLERS LOG

CODED

Date: March 28, 1963, Driller: H. G. Ladner County Harrison
 (Name)


	Description & Color of Materials Sand, Clay, Red Clay, Shell, etc.	Thick- ness Feet	Depth Feet
(1) Owner of Land: <u>J. C. Cobb</u> (Name) <u>Three Rivers Road</u> (Address)	<u>Red Clay</u> <u>Blue Clay</u>	<u>70</u> <u>435</u>	
(2) Location: <u>1/4</u> , <u>1/4</u> , Sec. <u>2 T22R10W</u> <u>15</u> miles <u>north</u> , of <u>Hamden</u> (distance) (direction) (Nearest Town)			
(3) Topography: <u>Flat</u> (Hilly) (Flat) (Level)			
(4) Purpose of Well: <u>Stock use</u> (Domestic Irrigation Municipal, Industrial, Other)			

CODED

Information upon completion of well:

- (1) Diameter 2 inches.
- (2) Total Depth 515 feet.
- (3) Water Level 20 feet below top of ground.
- (4) Cased to 505, Size 2 inch.
- (5) Screen: Size 2 inch Length 10.
- (6) Were any formations sealed against pollution?
 yes, no.

If YES depth of formation _____
 Why _____
 Drillers Remarks: _____

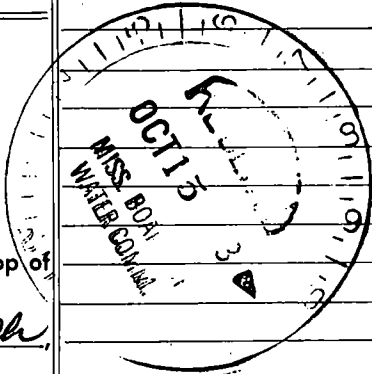

(Use Back Side)

Well No.




