

Harrison
M 190
B-66

MISSISSIPPI BOARD OF WATER COMMISSIONERS **CODED**

WATER WELL DRILLERS LOG

Date: 8-16, 1966, Driller: C.T. Switzer Well Co. County: Harrison
(When well drilled) (Name) (Where well is located)

(1) Owner of Land: Hi-speed Car Wash
(Name)

West Beach Biloxi, corner of
(Address)

(2) Location: SE 1/4, NE 1/4, Sec. 3 BT 7 R 9 W
1/4 miles W of PLOXI
(distance) (direction) (Nearest Town)

(3) Topography: X
(Hilly) (Flat) (Level)

(4) Purpose of Well: Domestic
(Domestic Irrigation, Municipal, Industrial, Other)

Description & Color of Materials Sand, Clay, Red Clay, Shell, etc.	Thick- ness Feet	Depth Feet
sand	0	40
clay	40	44
mixed	44	67
clay	67	68
sand	68	76
clay	76	88
sand	88	89
clay	89	137
mixed	137	148
sand	148	154
clay	154	262
mixed	262	285
clay	285	368
good sand	368	381
clay	381	464
sand	464	484
clay	484	591
Fuller's Earth	591	615
fine sand	615	632
fair sand	632	649
clay	649	651
sand	651	656
sand + clay streaks	656	670
good sand	670	682
broken fine sand	682	697
hard clay	697	719
clay + shale	719	742
shale	742	754
good	754	807

CODED

Information upon completion of well:

(1) Diameter 4 inches.

(2) Total Depth 807 feet.

(3) Water Level 22 feet below top of ground.

(4) Cased to 807', Size 4"

(5) Screen: Size 4" 8ga SS Length 40'

(6) Were any formations sealed against pollution?
X yes, no.

If YES depth of formation _____


Why: Health Dept. Permits

Drillers Remarks: _____

Yield in gpm: _____

Size pump: _____

Type power: _____

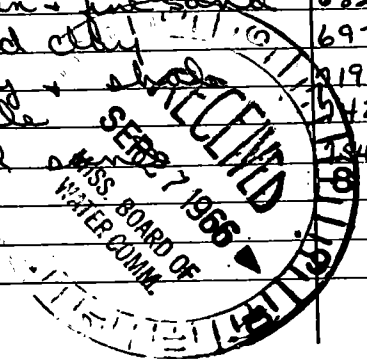







