HARRISON

~~[illegible]~~

M 347

6-22-72

MISSISSIPPI
BOARD OF WATER COMMISSIONERS

CODED

416 North State Street
Jackson, Mississippi 39201

WATER WELL DRILLERS LOG

HARRISON ~~[illegible]~~

6-22 1972 Switzer Well Company
date well completed — firm name — county well located

LANDOWNER: Andrew Fountain
180 Duff Stream Point
North Biloxi, Miss.
(mailing address)

WELL LOCATION:
sec. 22 T 7 S R 9 W
1 miles N of Biloxi
(distance) (direction) (nearest town)

WELL PURPOSE: Home
(home, irrigation, municipal, industrial)

WELL COMPLETION DATA:

(1) diameter (inches) 2"

(2) total depth (feet) 304'

(3) static water level (feet) -22' below ~~above~~ top of ground.

(4) casing galv. (material), 304' (depth),
(size) If telescope see back.

(5) screen 10' (length), 294' (depth to top)
008 (size), stainless steel (material)

(6) pump Owner furnished (HP) (yield gpm)
(type power)

(7) electric log — (yes or no)
(organization running log)

(8) how well bottom plugged back pressure valve

DRILLERS REMARKS:

description of formations encountered	from	to
clay	0	23
sand-gravel, white sand)	23	44
sand-gravel-clay	44	65
sand-soft clay	65	86
sand-clay mix	86	105
clay	105	126
sand	126	129
clay	129	215
sand	215	225
clay	225	233
sand	233	236
fine sand)	236	254
clay	254	269
fine sand)	269	279
fair sand	279	304

CODED

JUL 10 1972

If well telescopes please sketch and show depths.

GROUND LEVEL

If more than one screen, show locations of each on sketch.

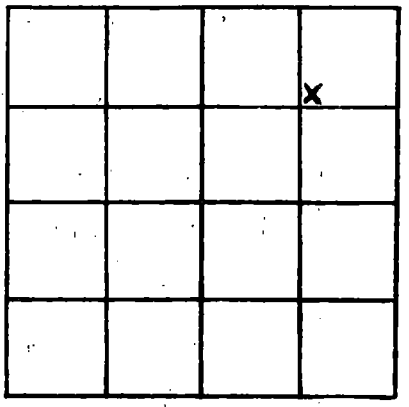

SECTION 22

Please indicate well location X.

ADDITIONAL INFORMATION