Harrison
M 418
5-7-69

MISSISSIPPI
BOARD OF WATER COMMISSIONERS
416 North State Street
Jackson, Mississippi 39201

CODED

WATER WELL DRILLERS LOG

MAY 7, 1969 — date well completed
MCGILL — firm name
HARRISON — county well located

LANDOWNER: SAM WILLIMS.
2213 KELLY AVU
(mailing address)

WELL LOCATION:
sec. 32 T 10 W/N/S R 7 S/E/W
1/2 miles NE of MISS. CITY
(distance) (direction) (nearest town)

WELL PURPOSE:
(home, irrigation, municipal, industrial)

WELL COMPLETION DATA:

(1) diameter (inches) 1 1/4
(2) total depth (feet) 20
(3) static water level (feet) 6 below above top of ground.
(4) casing ~~NONE~~ (material) (depth),
(size) if telescope see back.
(5) screen 5' (length), 15 (depth to top)
1 1/4 (size), S.S. (material)
(6) pump 1/2 (HP) 14 (yield gpm)
Elec (type power)
(7) electric log NO (yes or no)
(organization running log)
(8) how well bottom plugged B.W.

DRILLERS REMARKS:

description of formations encountered	from	to
TOP SOIL	0	10
SAND	10	20

CODED

JUN 30 1969
MISS. BD. OF WATER COMM.

If well telescopes please sketch and show depths.

GROUND LEVEL

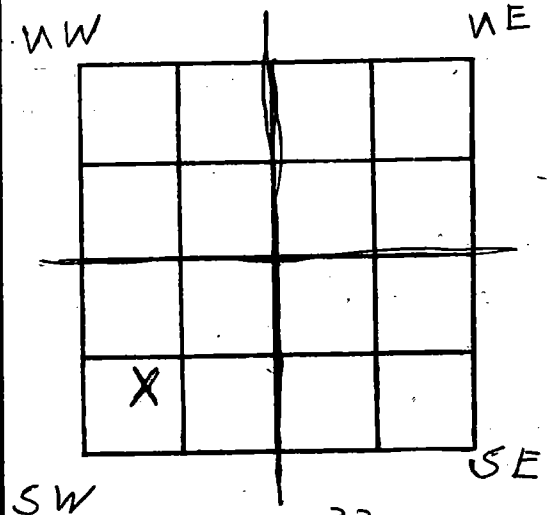

SECTION 32

Please indicate well location X.

ADDITIONAL INFORMATION

If more than one screen, show locations of each on sketch.