HARRISON
M538
2-11-72

MISSISSIPPI
BOARD OF WATER COMMISSIONERS
416 North State Street
Jackson, Mississippi 39201

CODED

MAR 9 1972

WATER WELL DRILLERS LOG

2-11 1972 Switzer Well Company Harrison
date well completed — firm name — county well located

LANDOWNER: Kenneth J. Thibodeaux
Rt. 5 Box 87F
Biloxi, Miss. 39532
(mailing address)

WELL LOCATION:
sec. 14 T. 7 S R. 10 W
1 3/4 miles N of Biloxi
(distance) (direction) (nearest town)

WELL PURPOSE: HOME
(home, irrigation, municipal, industrial)

WELL COMPLETION DATA:

(1) diameter (inches) 2"

(2) total depth (feet) 370'

(3) static water level (feet) 29'06" below above top of ground.

(4) casing galv. (material), 370' (depth),
— (size) if telescope see back.

(5) screen 10' (length), 360' (depth to top)
008 (size), stainless steel (material)

(6) pump 1 (HP) 10 (yield gpm)
ELECT (type power)

(7) electric log — (yes or no)
— (organization running log)

(8) how well bottom plugged back
Pressure Valve

DRILLERS REMARKS:

description of formations encountered	from	to
Clay	0	16
Sand	16	33
Clay	33	59
Sand	59	87
Clay	87	255
Sand-shale	255	260
Clay mixed shale	260	300
Sand	300	301
Sand-shell	301	303
Clay	303	322
Clay-shell mixed	322	338
Sand	338	343
Sand, good	343	370

CODED

If well telescopes please sketch and show depths.

GROUND LEVEL

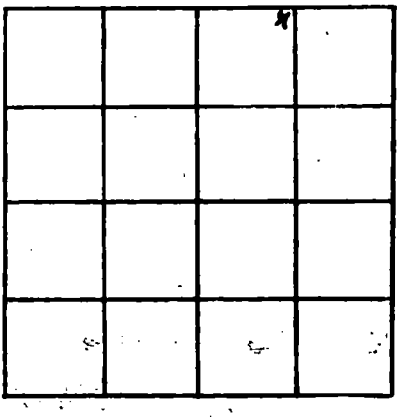

SECTION 14

Please indicate well location X.

ADDITIONAL INFORMATION

If more than one screen, show locations of each on sketch.