HARRISON
M545
9-8-72

MISSISSIPPI
BOARD OF WATER COMMISSIONERS
416 North State Street
Jackson, Mississippi 39201

WATER WELL DRILLERS LOG

CODED

9-8 1972 Switzer Well Co. HARRISON
date well completed | firm name | county well located

LANDOWNER: Preston Mallett
Rt 6 Box 386
North Biloxi Miss. 39532
(mailing address)

WELL LOCATION:
sec. 16 T 7 S R 9 W
2 miles N of Biloxi
(distance) (direction) (nearest town)

WELL PURPOSE: home
(home, irrigation, municipal, industrial)

WELL COMPLETION DATA:

(1) diameter (inches) 2"
(2) total depth (feet) 358'
(3) static water level (feet) -37' below above top of ground.
(4) casing poly, 358', (material) (depth)
_____ (size) If telescope see back.
(5) screen 10', 348' (length) (depth to top)
008, stainless steel (size) (material)
(6) pump 1/2 (HP) 6 (yield gpm)
ELECT (type power)
(7) electric log No (yes or no)
_____ (organization running log)
(8) how well bottom plugged back pressure valve

DRILLERS REMARKS:

description of formations encountered	from	to
clay	0	23
sand	23	38
clay	38	47
sand	47	55
clay	55	65
clay - sand str.	65	86
clay	86	129
clay - sand str.	129	150
clay	150	190
sand	190	193
clay	193	279
clay - sand str.	279	300
clay	300	315
sand, fine	315	321
sand, good	321	358

CODED

SEP 28 1972

If well telescopes please sketch and show depths.

GROUND LEVEL

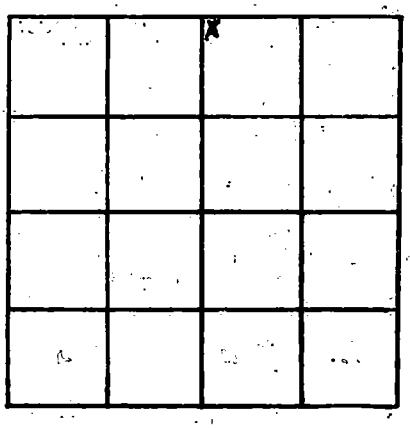

SECTION 16

Please indicate well location X.

ADDITIONAL INFORMATION

If more than one screen, show locations of each on sketch.