Coded

HARRISON
M595
6-10-73

MISSISSIPPI BOARD OF WATER COMMISSIONERS
416 North State Street
Jackson, Mississippi 39201

CODED

WATER WELL DRILLERS LOG

6-10-73 19 — R.J. Moore — HARRISON
date well completed — firm name — county well located

LANDOWNER: Joe Davis
Rt #1 Box 316
Biloxi, MS
(mailing address)

WELL LOCATION:
sec. 1 T 7 N (S) R 10 E (W)
1/2 (distance) miles East (direction) of Gorenia Estates (nearest town)

WELL PURPOSE: (home, irrigation, municipal, industrial)

WELL COMPLETION DATA:
(1) diameter (inches) 8"
(2) total depth (feet) 695'
(3) static water level (feet) 30' below above top of ground.
(4) casing Steel (material), 695' (depth), ___ (size) If telescope see back.
(5) screen 80' (length), 695' (depth to top), 8" (size), SS (material)
(6) pump — (HP) — (yield gpm) — (type power)
(7) electric log ___ (yes or no)
___ (organization running log)
(8) how well bottom plugged Pull Shoe

DRILLERS REMARKS:

description of formations encountered	from	to
Top Soil	0	10
White Clay	10	60
Blue Clay	60	2100
Blue Shale	2100	4.35
Blue Clay	4.35	530
Gray Shale	530	543
Blue Clay	543	600
Coarse Sand	600	610
Blue Clay	610	660
Coarse Gray Sand	660	695

JUL 23 1973

If well telescopes please sketch and show depths.

GROUND LEVEL

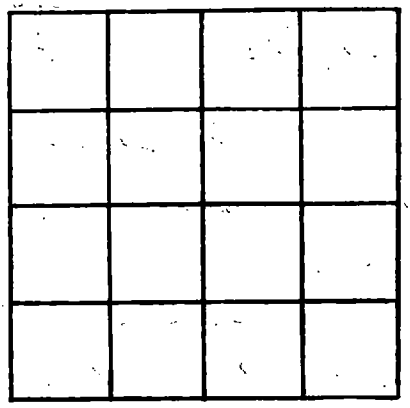

SECTION _____

Please indicate well location X.

ADDITIONAL INFORMATION

If more than one screen, show locations of each on sketch.