HARRISON
M 619
1-26-74

MISSISSIPPI
BOARD OF WATER COMMISSIONERS
416 North State Street
Jackson, Mississippi 39201

WATER WELL DRILLERS LOG

21 JAN 1974 BRYANT WELL CO HARRISON
date well completed — firm name — county well located

LANDOWNER: JOE E. Byrd
127 BLOWE Rd.
Biloxi, Miss. 39532
(mailing address)

WELL LOCATION:
sec. 16 T. 7 (N/S) R. 9 (E/W)
1 miles N of Biloxi
(distance) (direction) (nearest town)

WELL PURPOSE: HOME
(home, irrigation, municipal, industrial)

WELL COMPLETION DATA:
(1) diameter (inches) 2
(2) total depth (feet) 353
(3) static water level (feet) 38 below top of ground.
(4) casing Galv. (material), 353 (depth),
— (size) If telescope see back.
(5) screen 10' (length), 343 (depth to top)
2" (size), STAINLESS STEEL Wrapped. (material)
(6) pump 1 (HP) 18 (yield gpm)
ELECT (type power)
(7) electric log NO (yes or no)
(organization running log)
(8) how well bottom plugged METAL BACK PRESSURE VALVE

DRILLERS REMARKS:

description of formations encountered	from	to
Clay	0	10
Sand	10	18
Clay w/sand streaks	18	87
Shale	87	130
Fine Sand	130	159
Clay	159	163
Fine Sand	163	173
Clay	173	237
Fine Sand	237	247
Clay	247	258
Fine Sand	258	276
Clay	276	327
Coarse Sand	327	353

CODED

CODED

FEB

MISS. BD. OF WATER COMM.

If well telescopes please sketch and show depths.

GROUND LEVEL

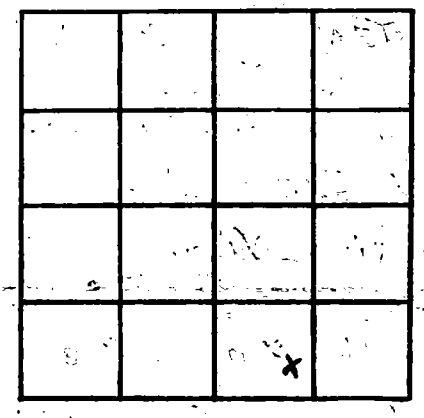

SECTION 16

Please indicate well location X.

ADDITIONAL INFORMATION

If more than one screen, show locations of each on sketch.