State Well Report

Part 1

Mississippi Department of Environmental Quality
Office of Land and Water Resources
P.O. Box 10631
Jackson, MS 39289-0631
(601) 961-5210
(601) 354-6938 (fax)

County: Harrison
Permit #:
Driller: Coast Water Wells RV.
Date drilling completed: 3-20-09

For Office Use Only:
Aquifer:
Well #: M-959
L. S. Elevation:
E-log #:

State Law requires that this report be prepared by the driller in detail and filed with the Department within 30 days of completion of drilling of the well.

Well Owner Information

Owner Name: Provias Construction Co.
Mailing Address: 149 Concourse Drive
Pearl, Ms 39208
City State Zip Code
Telephone No. (228) 218-1520

Well Location

Latitude: 30° 28' 309/19" Longitude: 088° 57' 609/37"
Method of Lat/Long (circle one): Conventional Survey, USGS quad, (Hand-held GPS), Survey-grade GPS
NW ¼ NW ¼ Sec 2 Twn T7S Rng R10W
Distance 1/2 Miles Direction EAST of Nearest Town WOOLMARKET

Well Data

Purpose of Well (circle one) Home Industrial Public Supply (Irrigation) Fish Culture Other:
Date well drilling started: 3-19-09 Date well drilling completed: 3-20-09
If flowing, method of flow regulation: Valve N/A Other (describe)
Static Water Level: 30 feet above or below (circle one) land surface Date measured: 3-20-09
Method of Measurement (circle one) steel tape electric tape (air line) other:
Hole depth: 456 FT Well depth: 456 FT Well grouted to a depth of 10 feet
Type of grout (circle one): Cement (Bentonite) Mix
Casing length: 226'X2" 200'X4" feet Casing diameter: 4X2 inches Type of casing: PVC
Screen length: 30 feet Screen diameter: 2 inches Type of screen: PVC
Screen slot size: .006 inches Setting depth: From 426 feet to 456 feet
Type of completion (circle all applicable): Gravel packed Underreamed Telescoped Open hole (Natural Development)
Other (describe):
Top of lap pipe or reduction in casing: N/A feet. If telescoped or more than one screen, describe on back of page
Logs run (circle all applicable): (No log run) Electric Gamma Ray Density Sonic Neutron Other:
Name of organization running log(s): N/A

I certify that the well was drilled, constructed, and completed in accordance with all applicable requirements of the Mississippi Department of Environmental Quality and/or the Mississippi Department of Health regulations and state laws.

Jack Ridgdell 0-472
Print Name of Water Well Contractor and License No.

Signature of Water Well Contractor

APR 08 2009
BY: OLWR

M-959

If well telescopes please sketch below and show depths.

Ground Level

Description of Formations Encountered	From	To
Top Soil	0	2
Gray and White clay	2	22
Blue clay w/ streaks of Sand	22	371
Gray low medium to Medium Sand	371	389
Gray Coarse Sand w/ Streaks of	389	410
Gray Curse Sand	410	456

If more than one screen, show location of each on sketch

Sketch the property layout and include the following: 1) the well location; 2) any permanent structures on the property that may aid in locating the well; 3) any roads, power lines, or other items that may aid in locating the property and the well; 4) indicate direction.

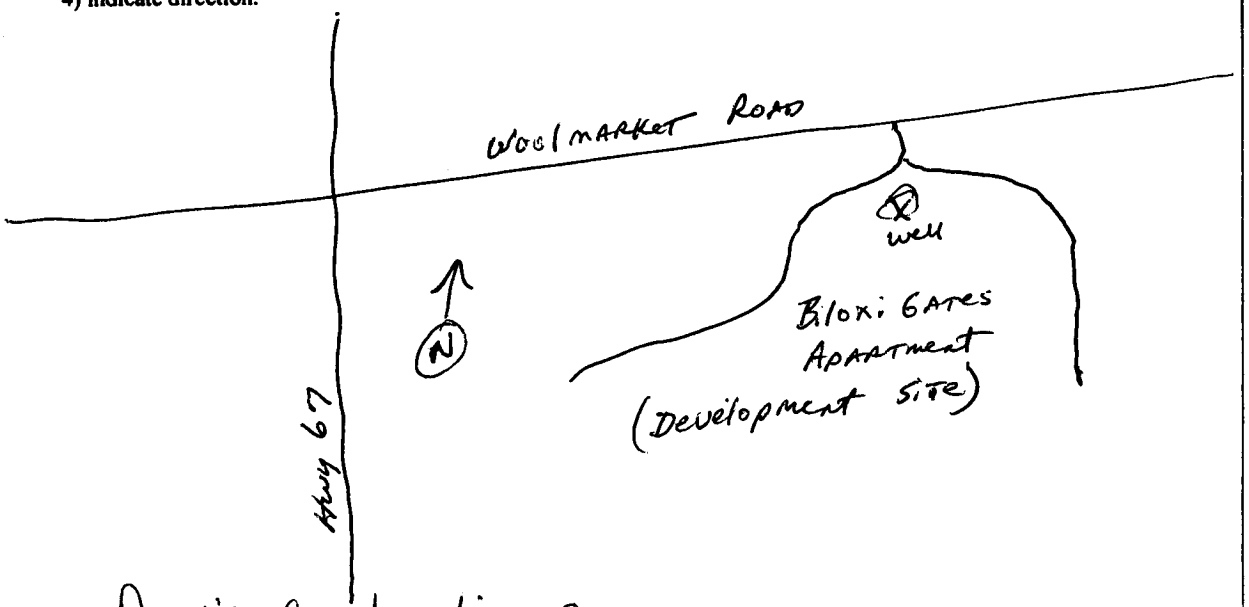

Landowner Name: Provias Construction Co.

Signature of Water Well Contractor

APR 08 2003
BY: OLWR

STATE WELL REPORT

Part 2

Pump Installer's Completion Report
Mississippi Department of Environmental Quality
Office of Land and Water Resources
P.O. Box 10631
Jackson, MS 39289-0631
(601) 961-5210
(601) 354-6938 (fax)

County: Harrison
Permit #:
Driller: Coastwater Well SRV.
Date completed: 3-20-09

For Office Use Only:
Aquifer:
Well #: M-959
Elevation:

This report should be prepared by the pump installer in detail and filed with the Department within 30 days of the installation of pump.

Well Owner Information

Owner Name: Provias Construction Co.
Mailing Address: 149 Concourse Drive
Pearl, Ms 39208
City State Zip Code
Telephone No. 228 218-1520

Well Location

Latitude: 30 28' 309" Longitude: 088 57' 609"
Method of Lat/Long (circle one): Conventional Survey,
USGS quad, (Hand-held GPS), Survey-grade GPS
NW ¼ NW ¼ Sec 2 Twn T7S Rng R10W
Distance Direction Nearest Town
1/2 Miles East of Woolmarket

Pump Type
Circle one

Air Lift | Jet | (Submersible)
Bucket | Piston | Turbine
Centrifugal | Rotary | Flowing Well
Other (specify):
Date Pump Installed: 3-20-09
Rated Pump Capacity: 40 Gallons Per Minute

Power Type
Circle one

(Diesel Engine) | Gasoline Engine | Natural Gas
Electric Motor | Hand | Tractor PTO
Windmill | Other (specify):
Horse Power Rating of Motor: 3HP
Setting Depth: 140 FT. Drop pipe feet
Number of Stages: 10

Pump Test Data

Date Well Tested: 3-20-09
Static Water Level (A): 90 Feet Below Land Surface
Pumping Water Level (B): N/A Feet Below Land Surface
Drawdown [(B) – (A)]: N/A Feet Below Land Surface
Test Pumping Rate: 48 Gallons Per Minute
Duration of Pump Test (minimum 4 hours): 5 hours

Method of Measuring Water Level
Circle one

(Air Line) | Electric Measuring Line | Steel Tape
Other (specify):
For flowing well, measured shut in head: N/A feet
Well yielded 65 GPM with a drawdown of
N/A feet after N/A hours of pumping

I HEREBY CERTIFY that the above statements are true to the best of my knowledge.

Jack Ridgdell 0-472
Print Name of Pump Installer and License No. (if applicable)

Signature of Pump Installer

APR 08 2009
BY: OLWR