HARRISON
M 2151
8/3/76

MISSISSIPPI BOARD OF WATER COMMISSIONERS

416 North State Street
Jackson, Mississippi 39201

138

WATER WELL DRILLERS LOG

8-3- 1976 McGill Well Works Harrison
date well completed — firm name — county well located

LANDOWNER: Ramona Hagwood
2416 Middle Cogg.
Gpt, Ms.
(mailing address)

WELL LOCATION:
sec. 32 T 7 N (S) R 10 E (W)
4 miles E of Gpt.
(distance) (direction) (nearest town)

WELL PURPOSE: lawn
(home, irrigation, municipal, industrial)

WELL COMPLETION DATA:
(1) diameter (inches) 2"
(2) total depth (feet) 30'
(3) static water level (feet) 3' (below) above top of ground.
(4) casing Sch 40, 20'
(material), (depth)
—
(size) If telescope see back.
(5) screen 10', —
(length), (depth to top)
2", plastic
(size), (material)
(6) pump 1/2, 14
(HP) (yield gpm)
electric
(type power)
(7) electric log no
(yes or no)
(organization running log)
(8) how well bottom plugged Capped

DRILLERS REMARKS:

description of formations encountered	from	to
Sand	0	30

RECEIVED
FEB 14 1977
MISS. BD. OF WATER COMM.

If well telescopes please sketch and show depths.

GROUND LEVEL

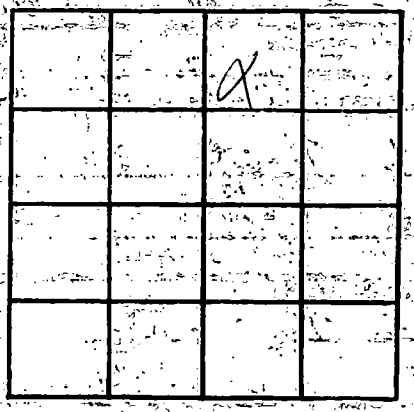

SECTION 22

Please indicate well location X.

ADDITIONAL INFORMATION

If more than one screen, show locations of each on sketch.