HARRISON
M 2168
8/17/76

135

MISSISSIPPI
BOARD OF WATER COMMISSIONERS
416 North State Street
Jackson, Mississippi 39201

WATER WELL DRILLERS LOG

8-17- 1976 McGee Well Works Harrison
date well completed — firm name — county well located

LANDOWNER: Mr. Mansfield
2418 19th Ave
Gpt. Mo.
(mailing address)

WELL LOCATION:
sec. 32 T 7 N (S) R 10 E (W)
4 miles E of Gpt.
(distance) (direction) (nearest town)

WELL PURPOSE: Lawn
(home, irrigation, municipal, industrial)

WELL COMPLETION DATA:
(1) diameter (inches) 2"
(2) total depth (feet) 30'
(3) static water level (feet) 3' below above top of ground
(4) casing PVC Sch. 40, 20'
(material), (depth)
— (size) If telescope see back.
(5) screen 10', —
(length), (depth to top)
2", Plastic
(size), (material)
(6) pump 1/2, 14
(HP), (yield gpm)
Electric
(type power)
(7) electric log no
(yes or no)
—
(organization running log)
(8) how well bottom plugged Capped

DRILLERS REMARKS:

description of formations encountered	from	to
Sand	0	30

RECEIVED
FEB - 9 1977
MISS. BD. OF WATER COMM.

If well telescopes please sketch and show depths.

GROUND LEVEL

If more than one screen, show locations of each on sketch.

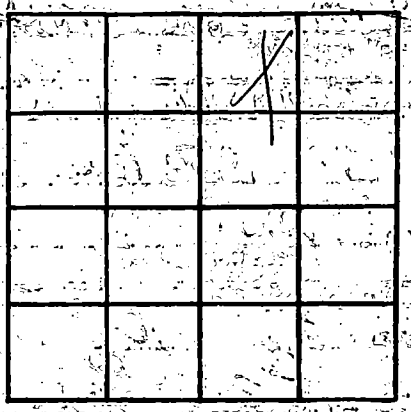

SECTION 22

Please indicate well location X.

ADDITIONAL INFORMATION