Harrison
M
2368

MISSISSIPPI DEPARTMENT OF NATURAL RESOURCES
Bureau of Land and Water Resources
Southport Mall
P.O. Box 10631
Jackson, Mississippi 39209

WATER WELL DRILLERS LOG

7/2 1982 Lyman Well Co. Harrison Cnty
date well completed — firm name — county well located

LANDOWNER: A. J Weagpver
Hwy 15
Biloxi, Miss 39531
(mailing address)

WELL LOCATION:
sec 26 T 7 N (S) R 10 E (W)
2 miles NW of Biloxi
(distance) (direction) (nearest town)

WELL PURPOSE: Home
(home, irrigation, municipal, industrial)

WELL COMPLETION DATA:
(1) diameter (inches) 2"
(2) total depth (feet) 238
(3) static water level (feet) 60' below above top of ground.
(4) casing PVC (material), 228 (depth), 2" (size) If telescope see back.
(5) screen 10' (length), 238 (depth to top), 2" (size), PVC (material)
(6) pump 1 (HP) 10 (yield gpm) Elect. (type power)
(7) electric log NO (yes or no) NO (organization running log) Sand Shark
(8) how well bottom plugged

description of formations encountered	from	to
Clay	0	200
Good Sand	200	238

DRILLERS REMARKS:

DEPT. OF NATURAL RESOURCES
BUREAU OF LAND & WATER RESOURCES
JUL 20 1982
RECEIVED

If well telescopes please sketch and show depths.

GROUND LEVEL

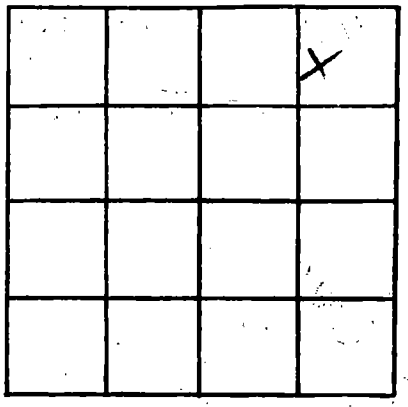

SECTION 26

Please indicate well location X.

ADDITIONAL INFORMATION

If more than one screen, show locations of each on sketch.