Harrison
M
2379

MISSISSIPPI DEPARTMENT OF NATURAL RESOURCES
Bureau of Land and Water Resources
Southport Mall
P.O. Box 10631
Jackson, Mississippi 39209

WATER WELL DRILLERS LOG

5-28-83 19 McDiLe Well World Inc. Harrison
date well completed — firm name — county well located

LANDOWNER: F.N. Lindberger
210 Randall Dr.
Biloxi, Ms. 39531
(mailing address)

WELL LOCATION:
sec. 29 T 7 N (S) R 10 E (W)
5 miles W of Gulfport
(distance) (direction) (nearest town)

WELL PURPOSE:
(home, irrigation, municipal, industrial)

WELL COMPLETION DATA:
(1) diameter (inches) 2"
(2) total depth (feet) 30'
(3) static water level (feet) 25' ~~below~~ above top of ground.
(4) casing PVC Sch 40, 20', (material) (depth)
(size) if telescope see back.
(5) screen 10', 20', (length) (depth to top)
2", Sch 40 PVC (size) (material)
(6) pump 1/2 10 (HP) (yield gpm)
elec (type power)
(7) electric log — (yes or no)
— (organization running log)
(8) how well bottom plugged Cap

DRILLERS REMARKS:

description of formations encountered	from	to
Sand	0	30

DEPT. OF NATURAL RESOURCES
BUREAU OF LAND & WATER RESOURCES
AUG 10 1983
RECEIVED

If well telescopes please sketch and show depths.

GROUND LEVEL

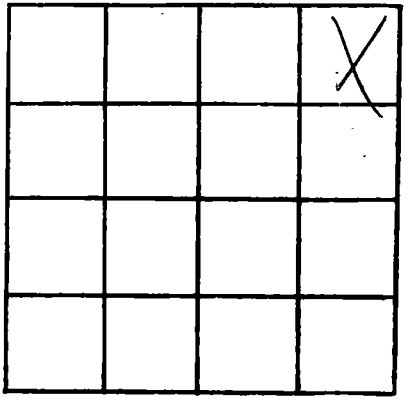

SECTION _____

Please indicate well location X.

ADDITIONAL INFORMATION

If more than one screen, show locations of each on sketch.