Harrison
M
2423

MISSISSIPPI DEPARTMENT OF NATURAL RESOURCES
Bureau of Land and Water Resources
Southport Mall
P.O. Box 10631
Jackson, Mississippi 39209

WATER WELL DRILLERS LOG

10/1/84 19 McGee Well Work Harrison
date well completed — firm name — county well located

LANDOWNER: Polk
28th St.
Gulf. Ms.
(mailing address)

WELL LOCATION:
sec 34 N S R 10 E W
3 miles N E of Gulf
(distance) (direction) (nearest town)

WELL PURPOSE: Home
(home, irrigation, municipal, industrial)

WELL COMPLETION DATA:

(1) diameter (inches) 2"

(2) total depth (feet) 260'

(3) static water level (feet) 20 above top of ground.

(4) casing Sch 40 PVC (material), 250' (depth),
— (size) if telescope see back.

(5) screen 10' (length), 250' (depth to top)
2" (size), Sch 80 6 slot (material)

(6) pump 1 (HP) 9 (yield gpm)
elec (type power)

(7) electric log — (yes or no)
— (organization running log)

(8) how well bottom plugged Seal

DRILLERS REMARKS:

description of formations encountered	from	to
mud	0	240
sand.	240	260

DEPT. OF NATURAL RESOURCES
BUREAU OF LAND & WATER RESOURCES
DEC - 8 1984
RECEIVED

If well telescopes please sketch and show depths.

GROUND LEVEL

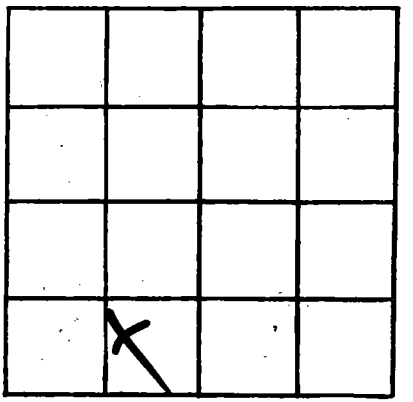

SECTION _____

Please indicate well location X.

ADDITIONAL INFORMATION

If more than one screen, show locations of each on sketch.