Harrison
M
2424

MISSISSIPPI DEPARTMENT OF NATURAL RESOURCES

Bureau of Land and Water Resources
Southport Mall
P.O. Box 10631
Jackson, Mississippi 39209

WATER WELL DRILLERS LOG

[illegible] Drilling & Service Co.
Rt. 1 Box 81
Biloxi, Miss. 39532

11/02/1984 19
date well completed

Harrison
county well located

LANDOWNER: Huey Page
2901 Sunny Hill
Gulfport, MS
(mailing address)

WELL LOCATION:
sec 34 T 7 N/S R 10 E/W
Gulfport miles (distance) (direction) of (nearest town)

WELL PURPOSE: home
(home, irrigation, municipal, industrial)

WELL COMPLETION DATA:

(1) diameter (inches) 2"
(2) total depth (feet) 480
(3) static water level (feet) 10 below ~~above~~ top of ground.
(4) casing PVC (material), 470 (depth),
(size) If telescope see back.
(5) screen 10' (length), 470 (depth to top)
2" (size), PVC (material)
(6) pump 1/2 (HP) 25 (yield gpm)
elc. (type power)
(7) electric log No (yes or no)
(organization running log)
(8) how well bottom plugged 2" back wash valve. 1973

DRILLERS REMARKS: None

description of formations encountered	from	to
top soil	1	5
sugarsand	5	25
red clay	25	160
coarse white sand	160	200
hard blue clay	200	310
coarse white sand	310	340
hard blue clay	340	460
fine water sand	460	470
good water sand	470	480

RECEIVED
FEB 14 1986
Department of Natural Resources
Bureau of Land & Water

If well telescopes please sketch and show depths.

GROUND LEVEL

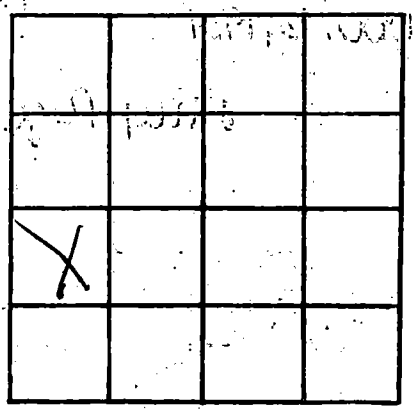

SECTION _____

Please indicate well location X.

ADDITIONAL INFORMATION

If more than one screen, show locations of each on sketch.