HARRISON
M 2462
5/16/85

MISSISSIPPI DEPARTMENT OF NATURAL RESOURCES

Bureau of Land and Water Resources
Southport Mall
P.O. Box 10631
Jackson, Mississippi 39209

WATER WELL DRILLERS LOG

COASTAL DRILLING & SUPPLY CO.
RT. 11, BOX 81
BILOXI, MS 39532

5/16/85 — date well completed
19 — farm name
Harrison — county well located

LANDOWNER: Nelson Rogers
Rt. 4 Box 72
Biloxi, MS
(mailing address)

WELL LOCATION:
sec. 3 T 6 ~~N~~ S R 10 ~~E~~ W
Woodmarket miles of
(distance) (direction) (nearest town)

WELL PURPOSE: Home
(home, irrigation, municipal, industrial)

WELL COMPLETION DATA:

(1) diameter (inches) 2"
(2) total depth (feet) 150
(3) static water level (feet) 10 below ~~above~~ top of ground.
(4) casing PVC (material), 140 (depth),
_____ (size) If telescope see back.
(5) screen 10 (length), 140 (depth to top)
2" (size), PVC (material)
(6) pump 1 (HP) 10 (yield gpm)
E/C (type power)
(7) electric log NO (yes or no)
_____ (organization running log)
(8) how well bottom plugged 2" back washed in 1978

DRILLERS REMARKS:

description of formations encountered	from	to
top soil	1	3
sugar sand	3	15
red clay	15	130
fine water sand	130	140
good water sand	140	150

RECEIVED
AUG 27 1985
Department of Natural Resources
Bureau of Land & Water Resources

If well telescopes please sketch and show depths.

GROUND LEVEL

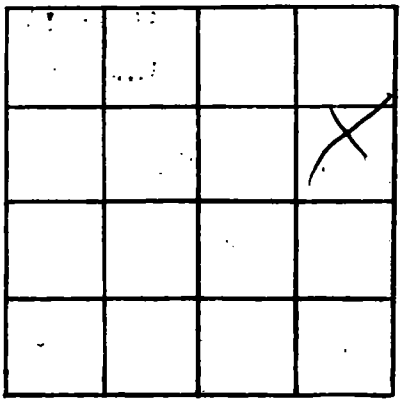

SECTION _____

Please indicate well location X.

ADDITIONAL INFORMATION

If more than one screen, show locations of each on sketch.