MISSISSIPPI DEPARTMENT OF NATURAL RESOURCES

Bureau of Land and Water Resources

P.O. Box 10631
Jackson, Mississippi 39209

WATER WELL DRILLERS LOG

COUNTY WELL LOCATED: Harrison	PERMIT NUMBER: 0239
WELL NUMBER: M 2508 CODED	NAME OF DRILLING FIRM: McGill Pump & Well
DATE WELL COMPLETED: 9/10/90	

NAME & MAILING ADDRESS OF LANDOWNER
Bruce Lee
11010 Three River Rd
Gpt. MS. 39505

WELL LOCATION: SEC 6 TOWNSHIP 7 N (S) RANGE 10 E (W)

DISTANCE 6 Miles DIRECTION East NEAREST TOWN Gpt. of

OTHER LANDMARK: Biloxi River Est.

WELL PURPOSE: (Home), Irrigation, Municipal, Industrial, Fish Pond, etc.

PUMP DATA

PUMP TYPE (Circle One): Submersible, Turbine, (Jet), Flowing Well, Other (Describe) _____

POWER TYPE (Circle One): (Electric), Tractor, Diesel, Gasoline, Butane, Other (Describe) _____ H/P _____

Pump Capacity (GPM)	No. of Stages	Setting Depth
12	2	50' FT.

PUMP TEST

Well yielded 15 GPM with a drawdown of 10 ft. after 1 hours of pumping

WELL DATA

Well Depth	Casing Diameter (In.)	Casing Length (Ft.)
420'	2"	20'

Type of Casing	Hole Depth	Depth to Static Water Level
PVC	420'	30'

TYPE OF COMPLETION: (Circle One or More): Gravel Packed, Underreamed, Telescoped, (Natural Development), Open Hole, Other (Describe) _____

Top of Lap Pipe or Reduction in Casing FEET

IF TELESCOPED OR MORE THAN ONE SCREEN: USE BACK PAGE

LOG DATA

TYPE OF LOG RUN (Circle One): (No Log Run), Electric, Gamma Ray, Density, Sonic, Neutron, Other (Describe) _____

Name of Organization Running Log

GEOLOGIC DATA (Office Use Only)

Surface Elev.	Geologic Unit	Unit Thickness	Depth to Top
Subs. SWL	Date	Analysis	Aquifer Test

Driller's Remarks

SCREEN DATA

Diameter - Inches	Length - Feet	Slot Size - Inches
2"	10'	.0006

Screen Type	Depth to Bottom - Feet
PVC	420'

DESCRIPTION OF FORMATIONS ENCOUNTERED	FROM	TO	FORMATIONS CONTINUED	FROM	TO
Mud	0	30			
Sand	30	70			
mud	70	220			
Sand	220	260			
mud	260	380			
Sand	380	420			
			IF MORE SPACE IS NEEDED, USE BACK		

RECEIVED
SEP 23 1991
Dept. of Environmental Quality
Bureau of Land & Water Resources

If well telescopes please
sketch and show depths.

GROUND LEVEL

If more than one screen,
show location of each on sketch.

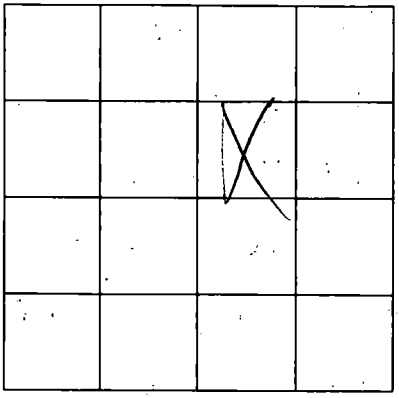

SECTION _____

Please indicate well location X.

ADDITIONAL INFORMATION