MISSISSIPPI DEPARTMENT OF ENVIRONMENTAL QUALITY
Bureau of Land and Water Resources

P. O. Box 10631
Jackson, MS 39289-0631
WATER WELL DRILLERS LOG

COUNTY WELL LOCATED	Harrison
WELL NUMBER	M 2524
CODED	
DATE WELL COMPLETED	9-6-89
PERMIT NUMBER	
NAME OF DRILLING FIRM	Coastal Drilling & Service Co. 8456 Woolmarket Biloxi Road Biloxi, Mississippi 39532

NAME & MAILING ADDRESS OF LANDOWNER	Mr. Sanders 4312 Oak Lawn Rd Biloxi, Ms
WELL LOCATION: SEC	18
TOWNSHIP	7 (N) (S)
RANGE	9 (E) (W)
DISTANCE	1 Miles
DIRECTION	N
NEAREST TOWN	of Magnolia Road
OTHER LANDMARK	Parker Creek
WELL PURPOSE: Home, Irrigation, Municipal, Industrial, Fish Pond, etc.	

PUMP DATA

PUMP TYPE (Circle One): Submersible, Turbine, (Jet) Flowing Well, Other (Describe) _____

POWER TYPE (Circle One): (Electric) Tractor, Diesel, Gasoline, Butane, Other (Describe) _____ H/P _____

Pump Capacity (GPM)	No. of Stages	Setting Depth
10	2	60 FT.

PUMP TEST

Well yielded 10 GPM with a drawdown of 0 ft. after 4 hours of pumping

WELL DATA

Well Depth	Casing Diameter (In.)	Casing Length (Ft.)
340'	2"	330'

Type of Casing	Hole Depth	Depth to Static Water Level
PVC	340'	40'

TYPE OF COMPLETION: (Circle One or More): Gravel Packed, Underreamed, Telescoped, (Natural Development), Open Hole, Other (Describe) _____

Top of Lap Pipe or Reduction in Casing

FEET — IF TELESCOPED OR MORE THAN ONE SCREEN: USE BACK PAGE

LOG DATA

TYPE OF LOG RUN (Circle One): No Log Run, Electric, Gamma Ray, Density, Sonic, Neutron, Other (Describe) _____

Name of Organization Running Log

GEOLOGIC DATA (Office Use Only)

Surface Elev.	Geologic Unit	Unit Thickness	Depth to Top
Subs. SWL	Date	Analysis	Aquifer Test

SCREEN DATA

Diameter - Inches	Length - Feet	Slot Size - Inches
2"	10'	.008

Screen Type	Depth to Bottom - Feet
PVC	340'

Driller's Remarks

None

DESCRIPTION OF FORMATIONS ENCOUNTERED	FROM	TO	FORMATIONS ENCOUNTERED	FROM	TO
top soil	1'	3'			
Red sand	3'	12'			
White sand	12'	20'			
soft Blue Clay	20'	65'			
Hard Blue Clay	65'	220'			
fine water sand	220'	250'			
Hard Blue clay	250'	300'			
fine watersand	300'	310'			
Coarse watersand	310'	340			
			IF MORE SPACE IS NEEDED, USE BACK		

RECEIVED
MAR 02 1992
Dept. of Environmental Quality
Bureau of Land & Water Resources

If well telescopes please
sketch and show depths.

GROUND LEVEL

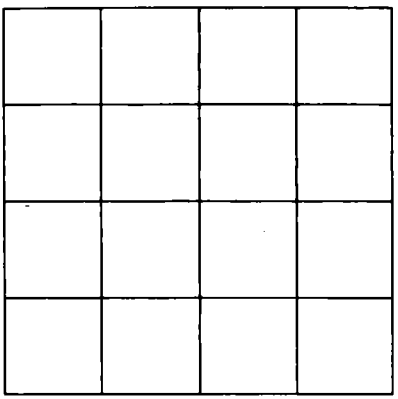

SECTION _____

Please indicate well location X.

ADDITIONAL INFORMATION

If more than one screen,
show location of each on sketch.