MISSISSIPPI DEPARTMENT OF ENVIRONMENTAL QUALITY
Office of Land and Water Resources

P. O. Box 10631
Jackson, MS 39289-0631
WATER WELL DRILLERS LOG

COUNTY WELL LOCATED: HARRISON	PERMIT NUMBER: 0404
WELL NUMBER: M 2563 / CODED:	NAME OF DRILLING FIRM: LYMAN WELL CO GULFPORT MS
DATE WELL COMPLETED: 10-10-95	

NAME & MAILING ADDRESS OF LANDOWNER
FORDICE CONSTRUCTION
P.O. BOX 1101
VICKSBURG, MS 39181

WELL LOCATION — SEC: 9 TOWNSHIP: 7 N (S) RANGE: 9 E (W)

DISTANCE ____ Miles DIRECTION ____ of NEAREST TOWN ____

OTHER LANDMARK: FAST LANE I10 & I110

WELL PURPOSE: Home, Irrigation, Municipal, Industrial, Fish Pond, etc.: Commercial

PUMP DATA

PUMP TYPE (Circle One): Submersible, Turbine, Jet, Flowing Well, Other (Describe) ____

POWER TYPE (Circle One): Electric, Tractor, Diesel, Gasoline, Butane, Other (Describe) ____ H/P 5

Pump Capacity (GPM)	No. of Stages	Setting Depth
		120' FT.

PUMP TEST

Well yielded ____ GPM with a drawdown of ____ ft. after ____ hours of pumping

WELL DATA

Well Depth	Casing Diameter (In.)	Casing Length (Ft.)
340'	4"	320'
Type of Casing	**Hole Depth**	**Depth to Static Water Level**
PVC		

TYPE OF COMPLETION: (Circle One or More): Gravel Packed, Natural Development, Underreamed, Open Hole, Telescoped, Other (Describe) ____

WELL GROUTED TO A DEPTH OF ____ FEET
Type Grout (circle one): Cement, Bentonite, or Mix

LOG DATA

TYPE OF LOG RUN (Circle One): Electric, Gamma Ray, Density, Sonic, Neutron, No Log Run, Other (Describe) ____

Name of Organization Running Log

GEOLOGIC DATA (Office Use Only)

Surface Elev.	Geologic Unit	Unit Thickness	Depth to Top
Subs. SWL	Date	Analysis	Aquifer Test

Driller's Remarks

Top of Lap Pipe or Reduction in Casing ____ FEET

IF TELESCOPED OR MORE THAN ONE SCREEN, USE BACK PAGE

SCREEN DATA

Diameter - Inches	Length - Feet	Slot Size - Inches
4"	20'	
Screen Type		**Depth to Bottom - Feet**
PVC		

RECEIVED
OCT 24 1995
Dept. of Environmental Quality
Office of Land & Water Resources

DESCRIPTION OF FORMATIONS ENCOUNTERED	FROM	TO

FORMATIONS (Continued)	FROM	TO

IF MORE SPACE IS NEEDED, USE BACK

If well telescopes please
sketch and show depths.

GROUND LEVEL

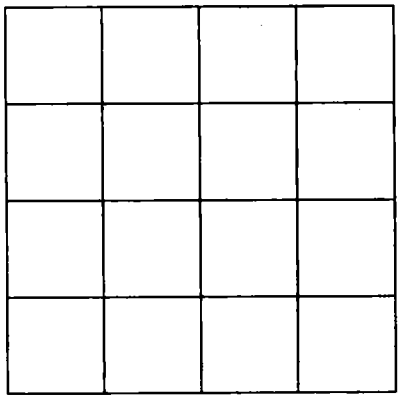

SECTION _____

Please indicate well location X.

ADDITIONAL INFORMATION

If more than one screen,
show location of each on sketch.