Harrison
N209
12-13-68

MISSISSIPPI
BOARD OF WATER COMMISSIONERS
416 North State Street
Jackson, Mississippi 39201

CODED

WATER WELL DRILLERS LOG

12-13 1968 Sutter Well Works Harrison
date well completed — firm name — county well located

LANDOWNER: Homer Gray
Pass Christian
Miss
(mailing address)

WELL LOCATION:
sec 27 T 8 N/S R 13 E/W
1 miles W of Pass Christian
(distance) (direction) (nearest town)

WELL PURPOSE: home
(home, irrigation, municipal, industrial)

WELL COMPLETION DATA:
(1) diameter (inches) 2
(2) total depth (feet) 329
(3) static water level (feet) 2 below ~~above~~ top of ground.
(4) casing gald (material), 324' (depth), 2" (size) if telescope see back.
(5) screen 5' (length), 324' (depth to top), 2" (size), stainless steel (material)
(6) pump unknown (HP) (yield gpm)
(type power)
(7) electric log no (yes or no)
(organization running log)
(8) how well bottom plugged BP Solid

DRILLERS REMARKS:

description of formations encountered	from	to
Sand	0	30
Clay	30	160
Sand	160	190
Clay	190	306
Sand	306	329

CODED

FEB 13 1969
MISS. BD. OF WATER COMM.

If well telescopes please sketch and show depths.

GROUND LEVEL

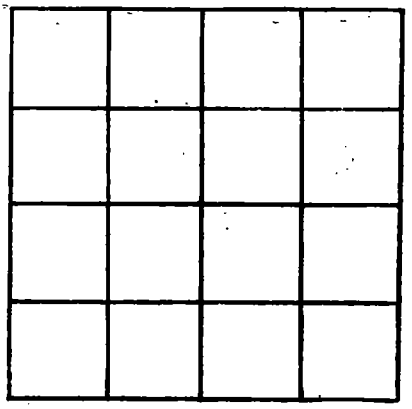

SECTION _____

Please indicate well location X.

ADDITIONAL INFORMATION

If more than one screen, show locations of each on sketch.