MISSISSIPPI DEPARTMENT OF ENVIRONMENTAL QUALITY
Bureau of Land and Water Resources

P. O. Box 10631
Jackson, MS 39289-0631
WATER WELL DRILLERS LOG

COUNTY WELL LOCATED: Harrison	
WELL NUMBER: N 333	CODED: ✓
PERMIT NUMBER: 0404	
NAME OF DRILLING FIRM: Lyman Well Co.	
DATE WELL COMPLETED: 1-7-92	Gulfport, Ms 39503

NAME & MAILING ADDRESS OF LANDOWNER: Gulf Const Community Action agency Inc.

WELL LOCATION: SEC. 16 TOWNSHIP 8 N/S RANGE 13 E/W

DISTANCE 5 Miles DIRECTION N of NEAREST TOWN Pass christ.

OTHER LANDMARK

WELL PURPOSE: Home, Irrigation, Municipal, Industrial, Fish Pond, etc.

PUMP DATA

PUMP TYPE (Circle One): Submersible, Turbine, Jet, Flowing Well, Other (Describe)

POWER TYPE (Circle One): Electric, Tractor, Diesel, Gasoline, Butane, Other (Describe) H/P

Pump Capacity (GPM)	No. of Stages	Setting Depth
108	12	65 FT.

PUMP TEST

Well yielded 108 GPM with a drawdown of 9 ft. after 24 hours of pumping

WELL DATA

Well Depth	Casing Diameter (In.)	Casing Length (Ft.)
760	6"	651

Type of Casing	Hole Depth	Depth to Static Water Level
SS	760	10'

TYPE OF COMPLETION: (Circle One or More): Gravel Packed, Underreamed, Telescoped, Natural Development, Open Hole, Other (Describe)

Top of Lap Pipe or Reduction in Casing FEET

IF TELESCOPED OR MORE THAN ONE SCREEN: USE BACK PAGE

LOG DATA

TYPE OF LOG RUN (Circle One): No Log Run, Electric, Gamma Ray, Density, Sonic, Neutron, Other (Describe)

Name of Organization Running Log: State

GEOLOGIC DATA (Reference Only)

Surface Elev.	Geologic Unit	Water Table Depth	Depth to Top
Subs. Sym.	Date	Analysis	Aquifer Test

RECEIVED SEP 01 1995 Dept. of Environmental Quality Office of Land & Water Resources

Driller's Remarks

SCREEN DATA

Diameter - Inches	Length - Feet	Slot Size - Inches
4"	30	6 slot

Screen Type	Depth to Bottom - Feet
Wrap SS	755

DESCRIPTION OF FORMATIONS ENCOUNTERED	FROM	TO

FORMATIONS (Continued)	FROM	TO
yellow & white clay	0	17
Sand and gravel	17	104
clay Blue gumbo	104	490
Sand good (Rusty)	490	555
Blue Clay	555	670
Sand good	670	760
IF MORE SPACE IS NEEDED, USE BACK		

If well telescopes please sketch and show depths.

GROUND LEVEL

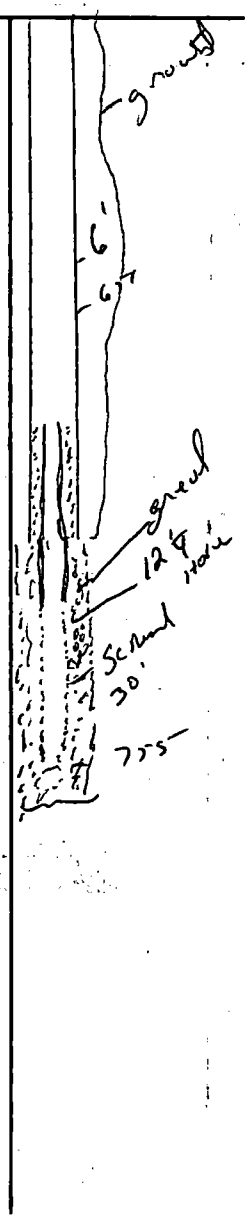

If more than one screen, show location of each on sketch.

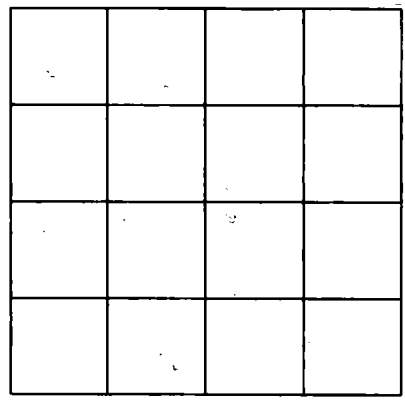

SECTION _____

Please indicate well location X.

ADDITIONAL INFORMATION