HARRISON
N 2015
7-1-77

138

MISSISSIPPI
BOARD OF WATER COMMISSIONERS
416 North State Street
Jackson, Mississippi 39201

WATER WELL DRILLERS LOG

7-1 (date well completed) 19 77 McGill Well Works Inc. (firm name) Harrison (county well located)

LANDOWNER: Billy Broome
Rt. 3, Box 580
Bay Christian, Ms. 39571
(mailing address)

WELL LOCATION:
sec. 8 T 8 N (S) R 13 E (W)
*2½ (distance) miles 5.E (direction) of Delisle (nearest town)

WELL PURPOSE: home
(home, irrigation, municipal, industrial)

WELL COMPLETION DATA:

(1) diameter (inches) 2"
(2) total depth (feet) 240'
(3) static water level (feet) 4' ~~below~~ above top of ground
(4) casing Sch. 40 (material), 230' (depth), — (size) if telescope see back.
(5) screen 10' (length), — (depth to top), 2" (size), plastic (material)
(6) pump 1/2 HP (HP), 12 (yield gpm)
electric (type power)
(7) electric log no (yes or no)
— (organization running log)
(8) how well bottom plugged Sand Shank

DRILLERS REMARKS: —

description of formations encountered	from	to
Clay	0	20
Sand	20	68
Slush	68	118
Blue clay	118	163
Fine sand	163	209
Course sand	209	240

RECEIVED
JUL 11 1977
MISS. BD. OF WATER COMM.

If well telescopes please sketch and show depths.

GROUND LEVEL

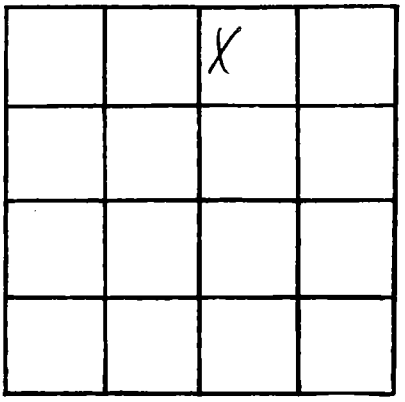

SECTION 8

Please indicate well location X.

ADDITIONAL INFORMATION

If more than one screen, show locations of each on sketch.