Harrison
026
1-9-68

MISSISSIPPI
BOARD OF WATER COMMISSIONERS
416 North State Street
Jackson, Mississippi 39201

CODED

WATER WELL DRILLERS LOG

~~Dec~~ Jan 9 1968 — date well completed
M&B Drilling Co — firm name
Harrison — county well located

LANDOWNER Louis Beasley
Gates Ave.
Long Beach, Miss
(mailing address)

WELL LOCATION:
sec. 12 T 8 N/S R 12 E/W
1 (distance) miles N (direction) of Long Beach (nearest town)

WELL PURPOSE: Home
(home, irrigation, municipal, industrial)

WELL COMPLETION DATA:
(1) diameter (inches) 4"
(2) total depth (feet) 450
(3) static water level (feet) 4 below ~~above~~ top of ground.
(4) casing PVC (material), 425 (depth), 4" (size) X 2½" if telescope see back.
(5) screen ~~[illegible]~~ 20 (length), 425 (depth to top), ~~[illegible]~~ (size), ~~[illegible]~~ (material) .008
(6) pump 1 (HP), 20 (yield gpm)
220 1Ø (type power) Burks Submer.
(7) electric log No (yes or no)
(organization running log)
(8) how well bottom plugged ~~[illegible]~~ 2½" B.W. Valve

DRILLERS REMARKS:

description of formations encountered	from	to
Sand	0	23
Gray Clay	23	32
Sand	32	35
Soft Gray Clay	35	40
Sand	40	45
Gray Clay	45	105
Sand	105	108
Blue Clay	108	180
Sand - Fine	180	212
Blue Clay	212	250
~~Good~~ Sand	250	260
Blue Clay	260	380
Sandy Clay Breaks	380	418
Rock	418	420
Sand	420	444
Blue Clay	444	450
		+

CODED

JAN 21 1969
MISS. BD. OF WATER COMMS

If well telescopes please sketch and show depths.

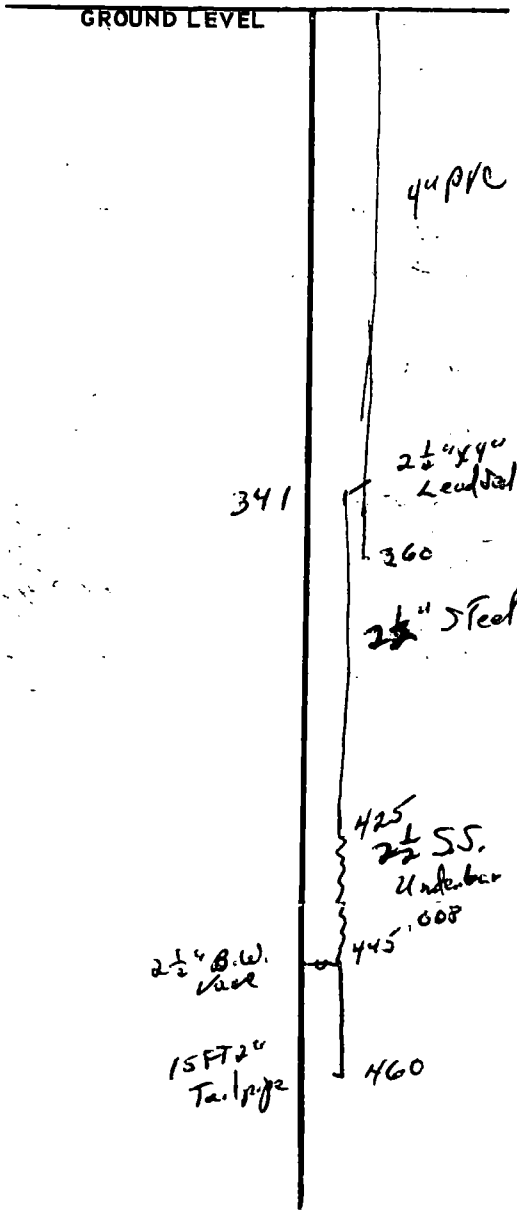

If more than one screen, show locations of each on sketch.

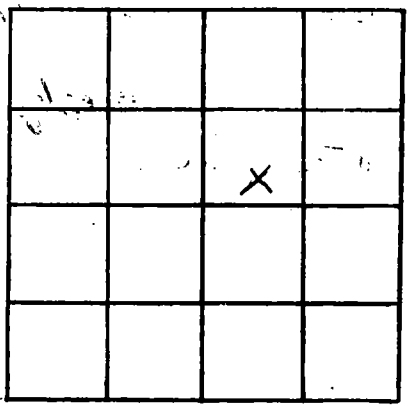

SECTION 12

Please indicate well location X.

ADDITIONAL INFORMATION