

HAR. MISSISSIPPI BOARD OF WATER COMMISSIONERS

031  
10-19-61

WATER WELL DRILLERS LOG

CODED 318

Date: 10-19, 1961, Driller: Sutter Well Wks. County Harrison

(Name)

(1) Owner of Land: Walter Byrom  
(Name)  
Rt 1 Pass Christian Miss.  
(Address)

(2) Location: NW 1/4, SE 1/4, Sec. 8 T8S R12W  
1/2 miles E of CEEVAS  
(distance) (direction) (Nearest Town)

(3) Topography: flat  
(Hilly) (Flat) (Level)

(4) Purpose of Well: Domestic  
(Domestic Irrigation  
Municipal, Industrial, Other)

Description & Color of Materials  
Sand, Clay, Red Clay, Shell, etc.

Thick-  
ness  
Feet

Depth  
Feet

Surface Clay	10	10
Sand	25	35
Clay	70	105
Sand	15	120
Clay	50	170
Sand	22	192


Information upon completion of well:

- (1) Diameter 2 inches.
- (2) Total Depth 192 feet.
- (3) Water Level 13 feet below top of ground.
- (4) Cased ~~to~~ cell, Size 2"
- (5) Screen: Size 2", Length 5'
- (6) Were any formations sealed against pollution?  
\_\_\_\_\_ yes,  no.

If YES depth of formation \_\_\_\_\_

Why \_\_\_\_\_

Drillers Remarks: \_\_\_\_\_

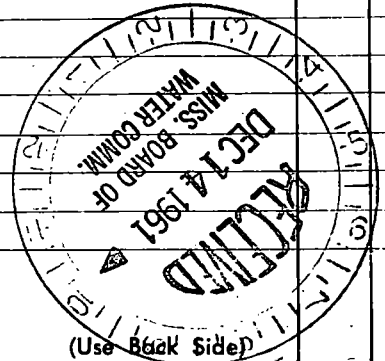

(Use Back Side)

Well No.





