

HAR.

0 16
4-23-65

MISSISSIPPI BOARD OF WATER COMMISSIONERS

WATER WELL DRILLERS LOG

~~CODED~~

Date: 4-23, 1965, Driller: Sutter Wood Works County Harrison
(Name)

- (1) Owner of Land: Alden Keel
(Name)
Pass Christian
(Address)
- (2) Location: Nw 1/4, Sw 1/4, Sec. 8 T8S R12W
1 miles S of Cuevas
(distance) (direction) (Nearest Town)
- (3) Topography: flat
(Hilly) (Flat) (Level)
- (4) Purpose of Well: domestic
(Domestic Irrigation
Municipal, Industrial, Other)

Description & Color of Materials Sand, Clay, Red Clay, Shell, etc.	Thick- ness Feet	Depth Feet
<u>clay</u>	<u>10</u>	<u>10</u>
<u>sand</u>	<u>25</u>	<u>35</u>
<u>Clay - sand streaks</u>	<u>343</u>	<u>378</u>
<u>clay</u>	<u>26</u>	<u>404</u>
<u>sand</u>	<u>23</u>	<u>427</u>
<u>clay</u>	<u>113</u>	<u>540</u>
<u>sand</u>	<u>40</u>	<u>580</u>


Information upon completion of well:

- (1) Diameter 2 1/2 inches.
- (2) Total Depth 580 feet.
- (3) Water Level 4 feet above below top of ground.
- (4) Cased to all, Size 2 1/2"
- (5) Screen: Size 2", Length 10'
- (6) Were any formations sealed against pollution?
no.

If YES depth of formation _____

Why _____

Drillers Remarks: _____

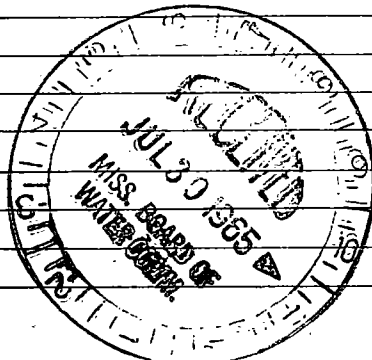

(Use Back Side)

Well No.







